


T.11S. R.5W.W.M.

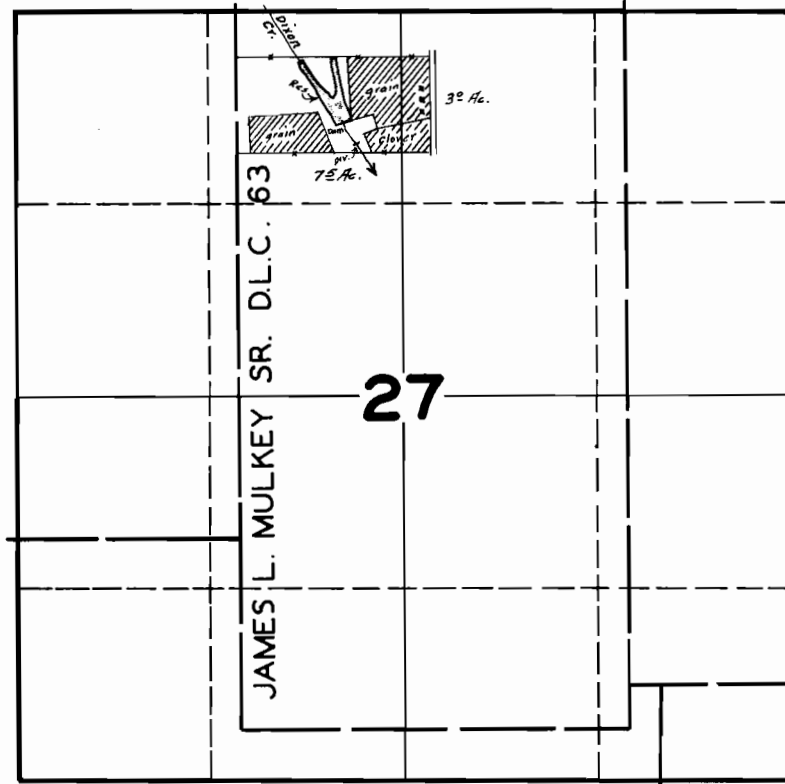

FINAL PROOF SURVEY

UNDER

20239

15780

Application No. R-20256 Permit No. R-790

IN NAME OF

GODFREY V. COPSON

Surveyed JULY 6, 1945, by

James L. Mulkey