


T.2S.R.4E.W.M.

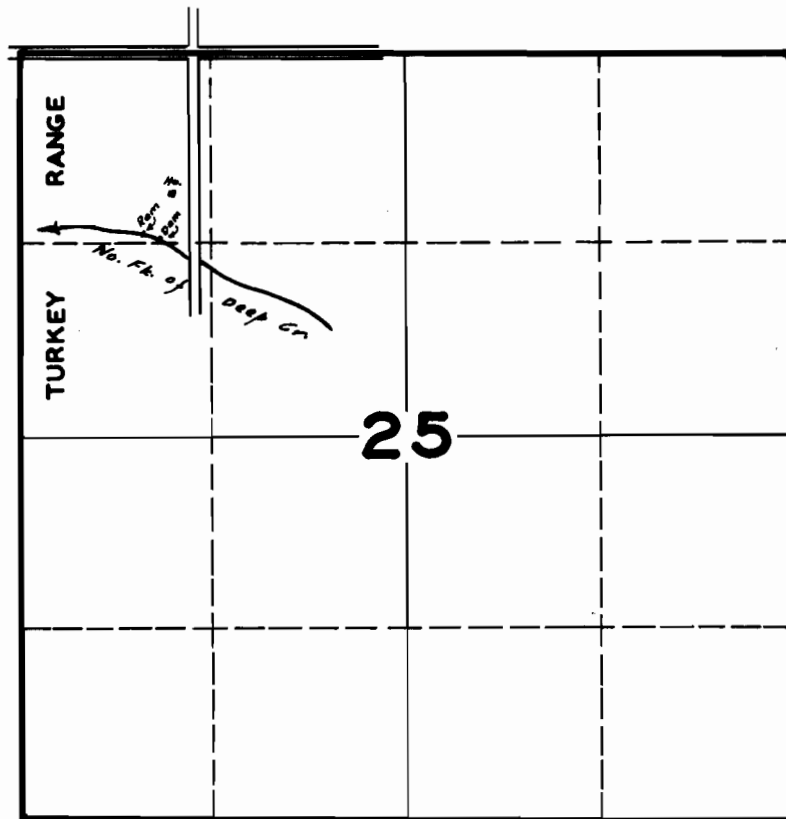

**FINAL PROOF SURVEY
UNDER**

Application No. 19501 Permit No. 15101

IN NAME OF

CARL J. SANDSTROM 3

Surveyed JUNE 18 1946, by J. B. Russell