


# T.4S.R.3E.W.M.

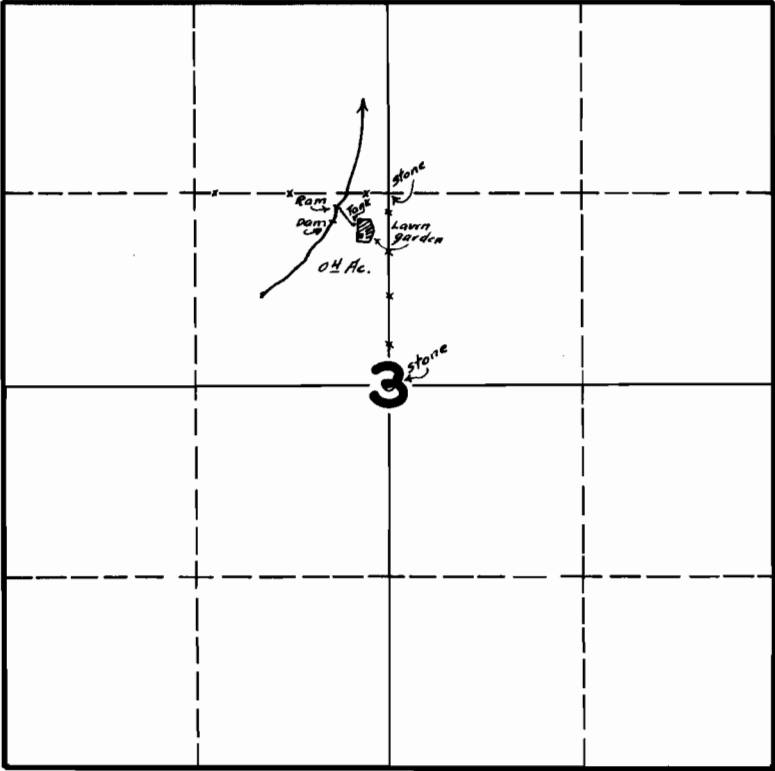

## FINAL PROOF SURVEY UNDER

Application No. 20309 Permit No. 15843

IN NAME OF

R. M. BENNETT

Surveyed JUNE 191946 by J. C. Russell