


T.2N.R.2W.W.M.

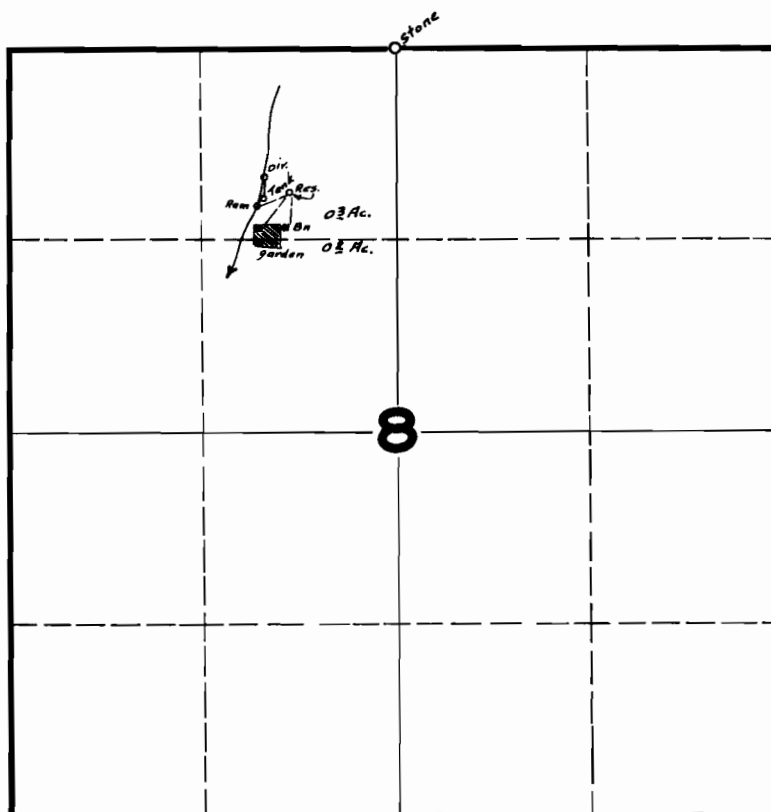

FINAL PROOF SURVEY
UNDER

Application No. 21100 Permit No. 16535

IN NAME OF
G.H. BALDWIN

Surveyed AUG. 26 1946, by James S. Sumrell