


# T.30S. R.4W.W.M.

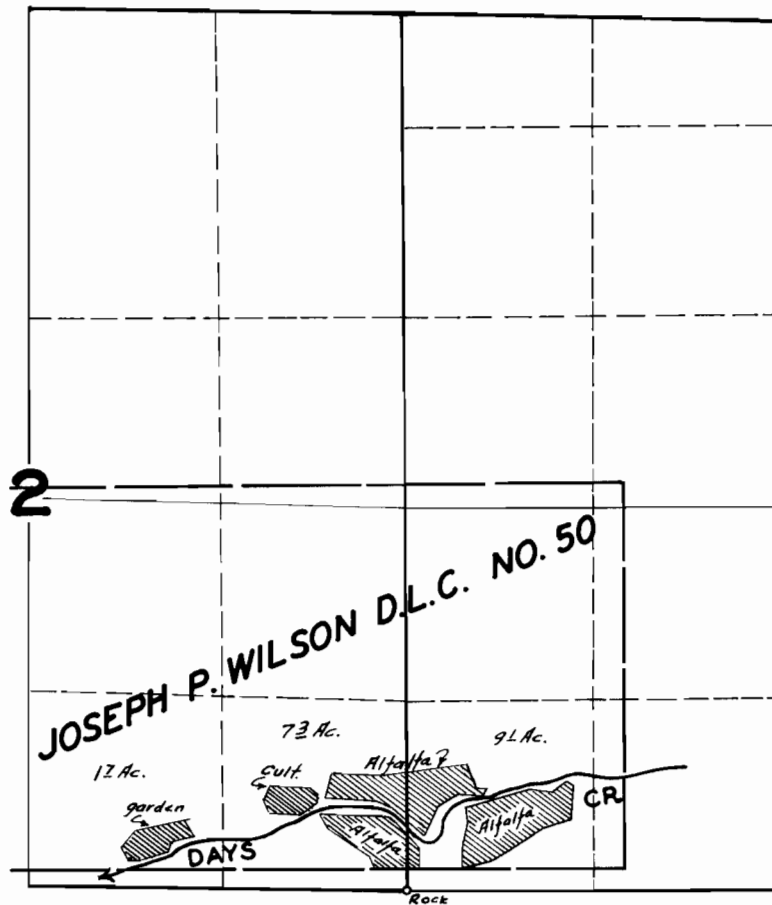

## FINAL PROOF SURVEY UNDER

Application No. 15644 Permit No. 11499

IN NAME OF

NATALIE BAUM

Surveyed JULY 10, 1947, by JAS. E. BUNNELL