


T.3S.R.4W.W.M.

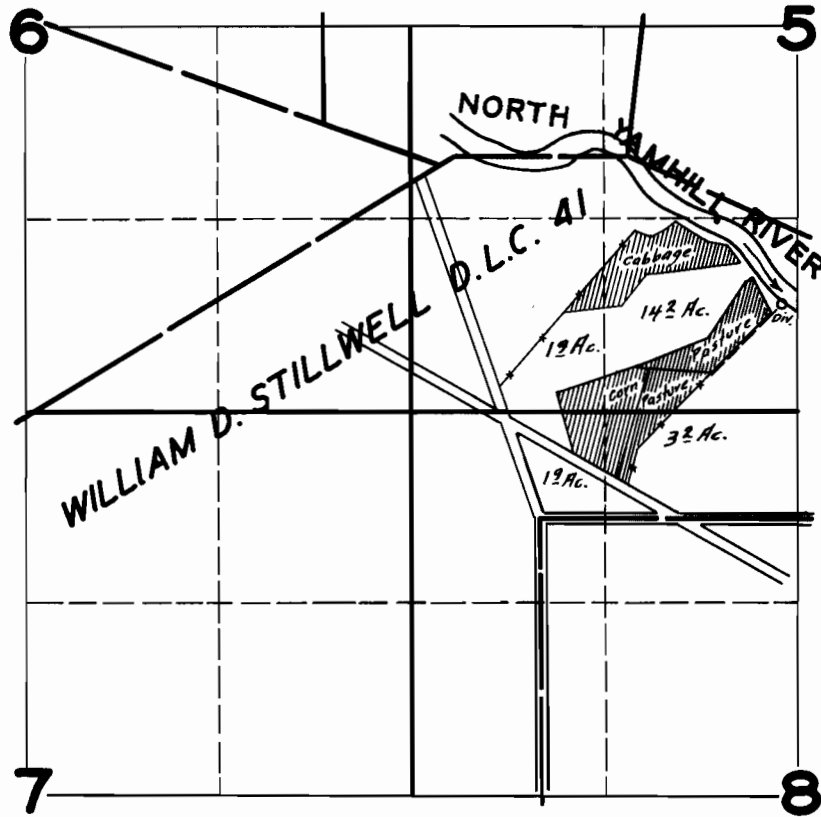

FINAL PROOF SURVEY UNDER

Application No. 17593 Permit No. 13289

IN NAME OF

CHARLES G. BAUER

Surveyed SEP. 6. 1946, by