


T.4S.R.3W.W.M.

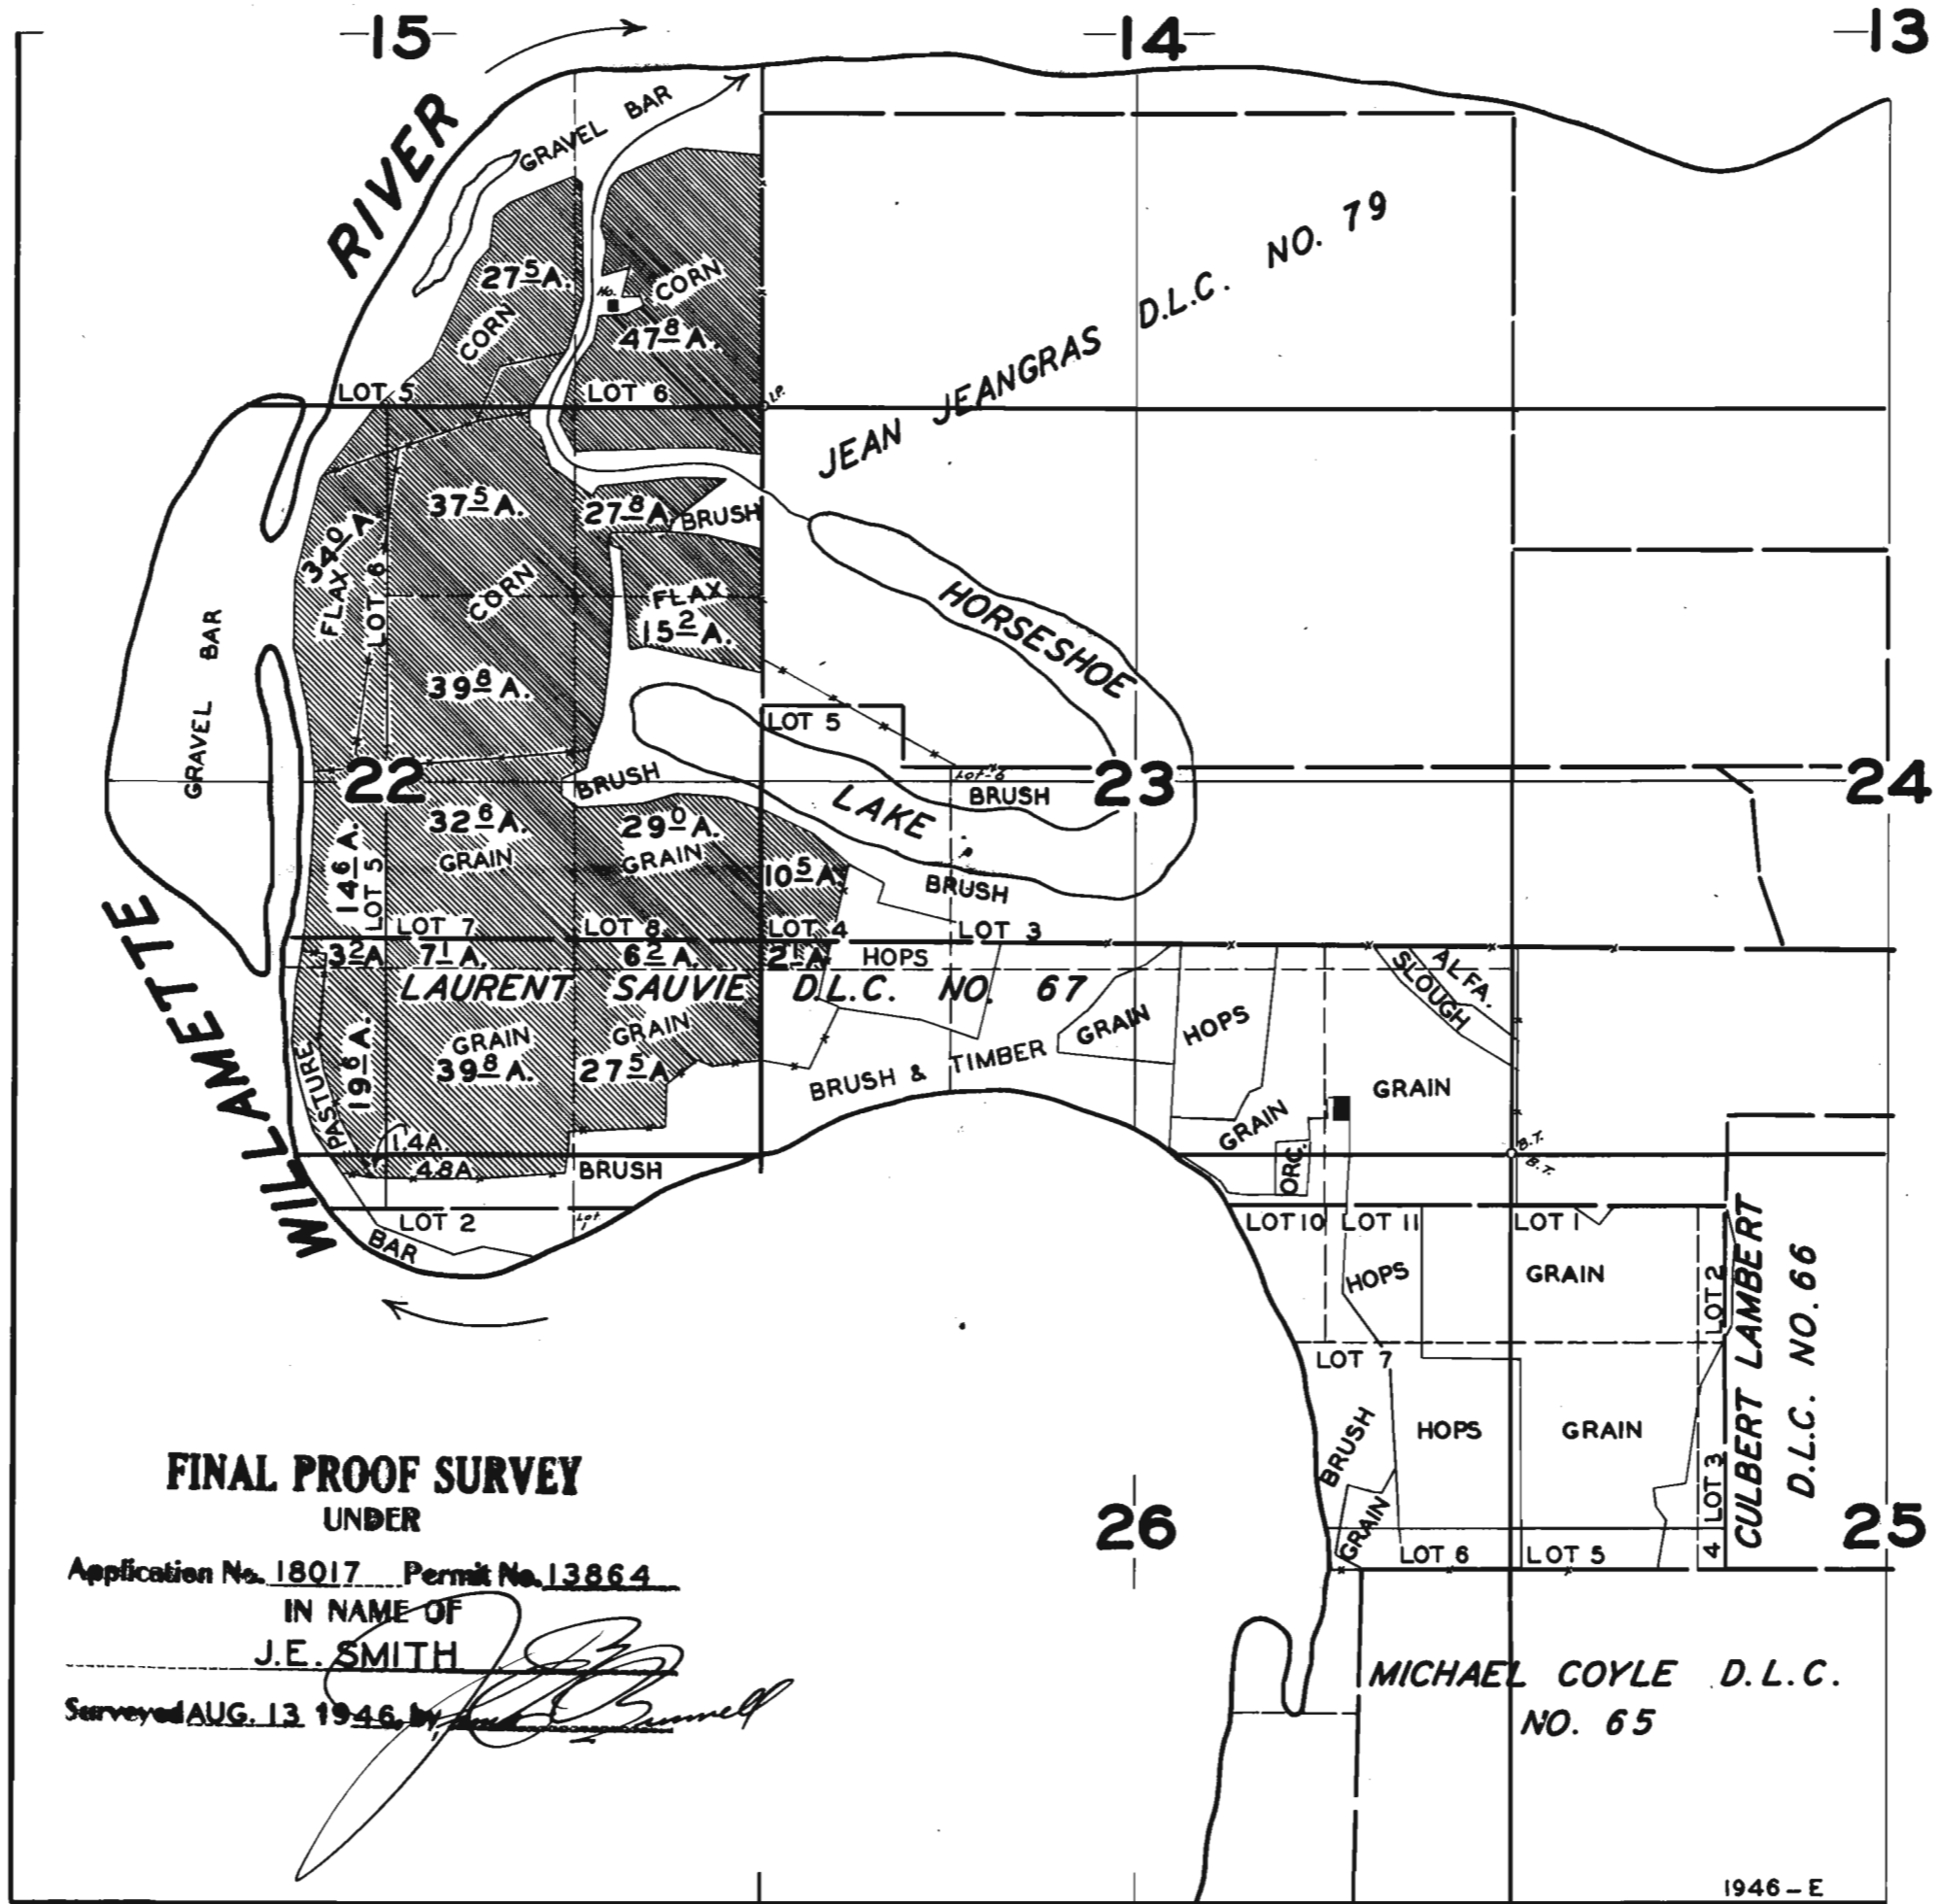

Trim Line 2

Trim Line 4