


T.7S.R.36&37E.W.M.

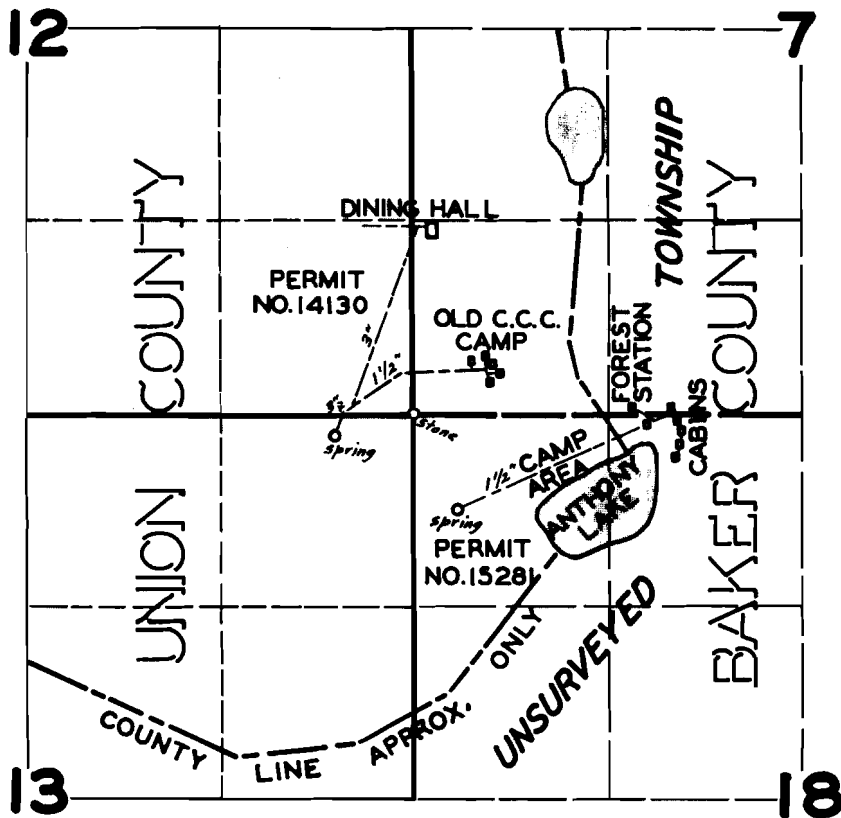

FINAL PROOF SURVEY

UNDER

18587

14130

Application No. 19703

Permit No. 15281

IN NAME OF

U.S. FOREST SERVICE-WHITMAN NATIONAL FOREST

Surveyed JULY 4, 1946, by

[Signature]