


Per 14158
15726

T. 9 & 10 S. R. 28 E. W. M.

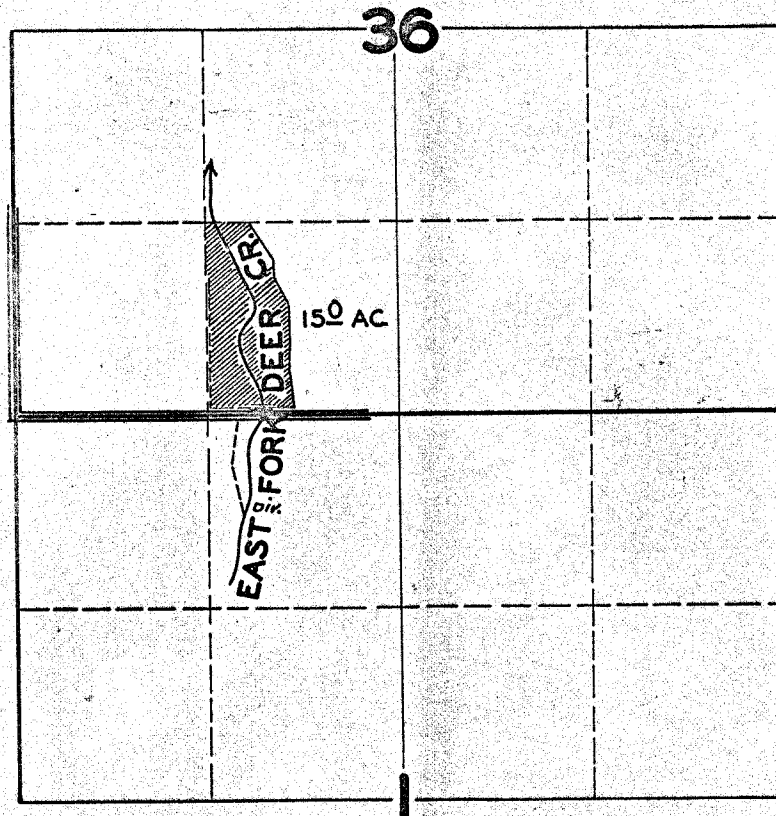

FINAL PROOF SURVEY
UNDER

Application No. 18493 Permit No. 14158

IN NAME OF
FRED W. LEGLER

Surveyed APR. 25 1946 by *James E. Russell*