


T.4S. R.1E.W.M.

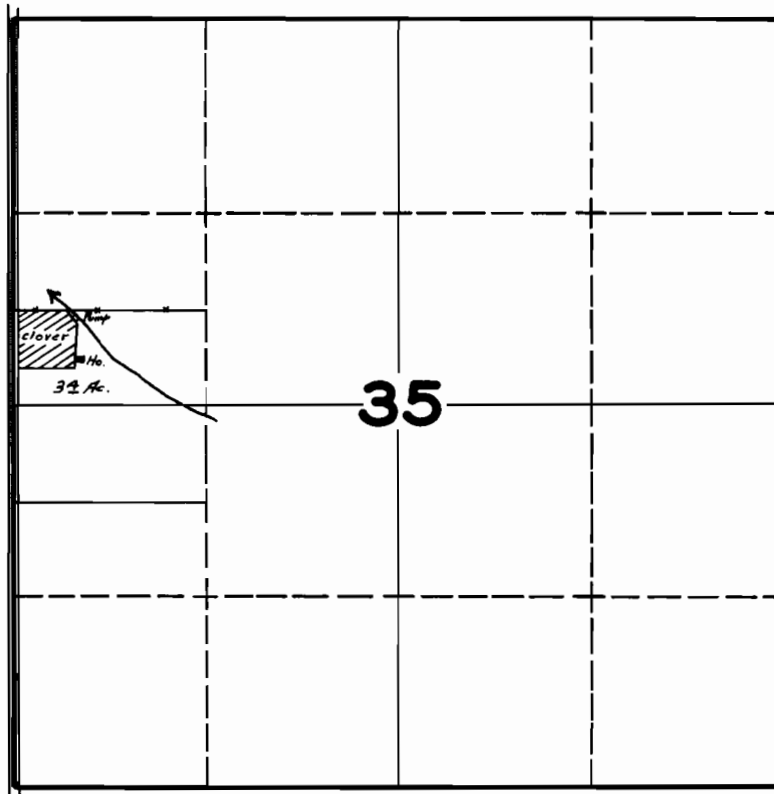

**FINAL PROOF SURVEY
UNDER**

Application No. 18576 Permit No. 14190

IN FAVOR OF

ALBERT R. WILLBROAD

Surveyed SEPT. 5 1944, by *Paul C. Russell*