


T. IN. R. 14 E. W. M.

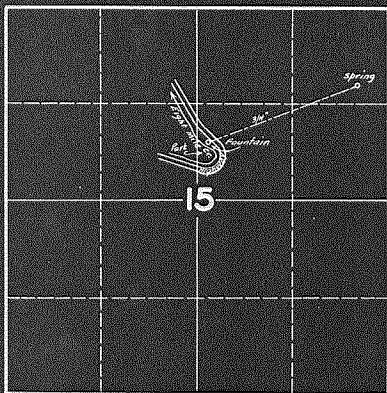

FINAL PROOF SURVEY  
UNDER

Application No. 18464 Permit No. 14206

IN NAME OF

STATE OF OREGON—STATE HIGHWAY COMMISSION

Surveyed APR. 10, 1946, by JAS. E. BUNNELL