


Per 14256
15729

T.9S.R.28E.W.M.

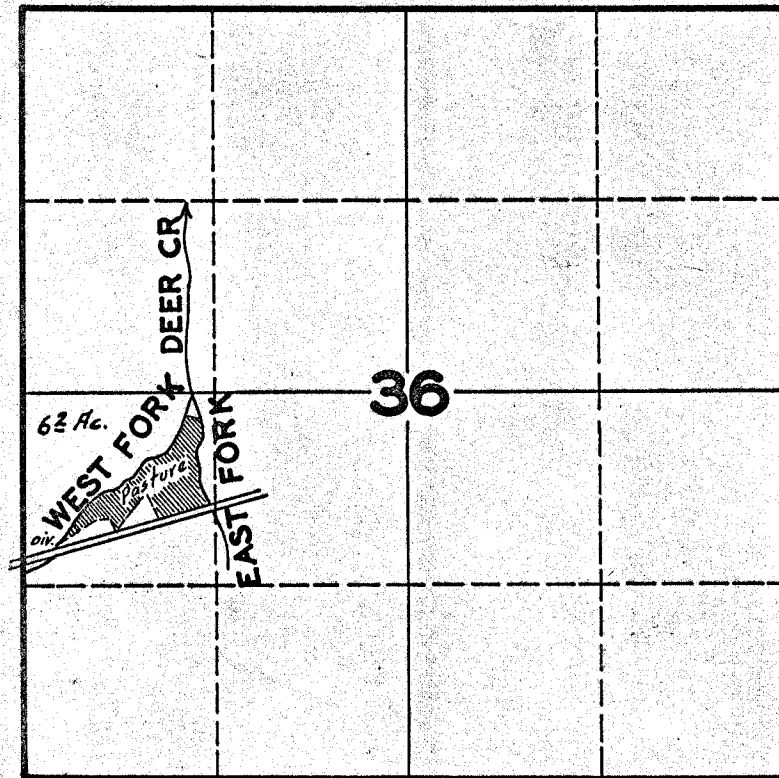

**FINAL PROOF SURVEY
UNDER**

Application No. 18618 Permit No. 14256

IN NAME OF

JAMES R. CRISWELL

Surveyed APR. 24 1946, by

[Signature]