


T. 18S. R. 2W. W.M.

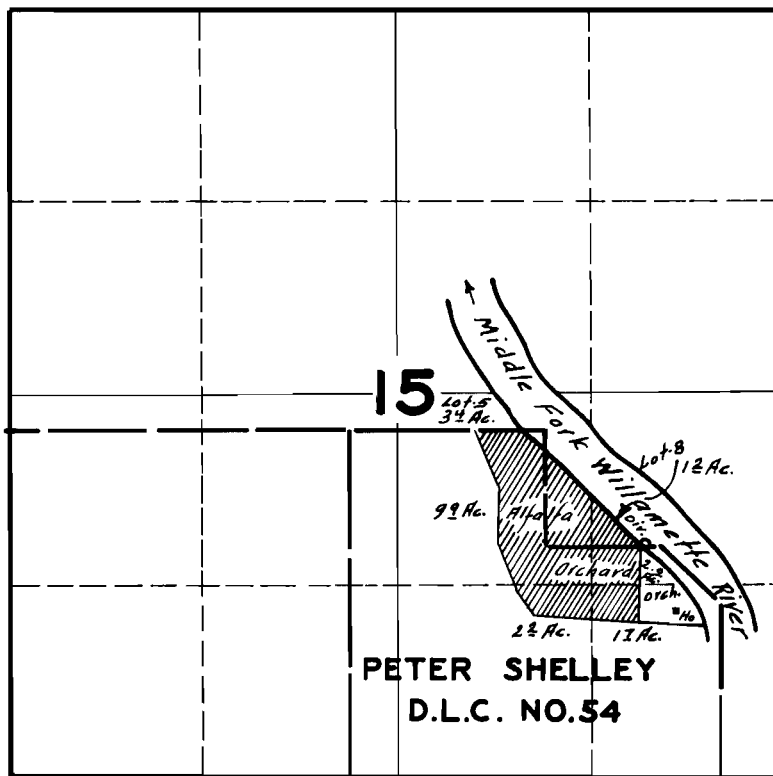

FINAL PROOF SURVEY UNDER

Application No. 18697 Permit No. 14372

IN NAME OF

M. L. WALLACE

Surveyed JULY 25 1948, by [Signature]