


T. 19S. R. 3W. W.M.

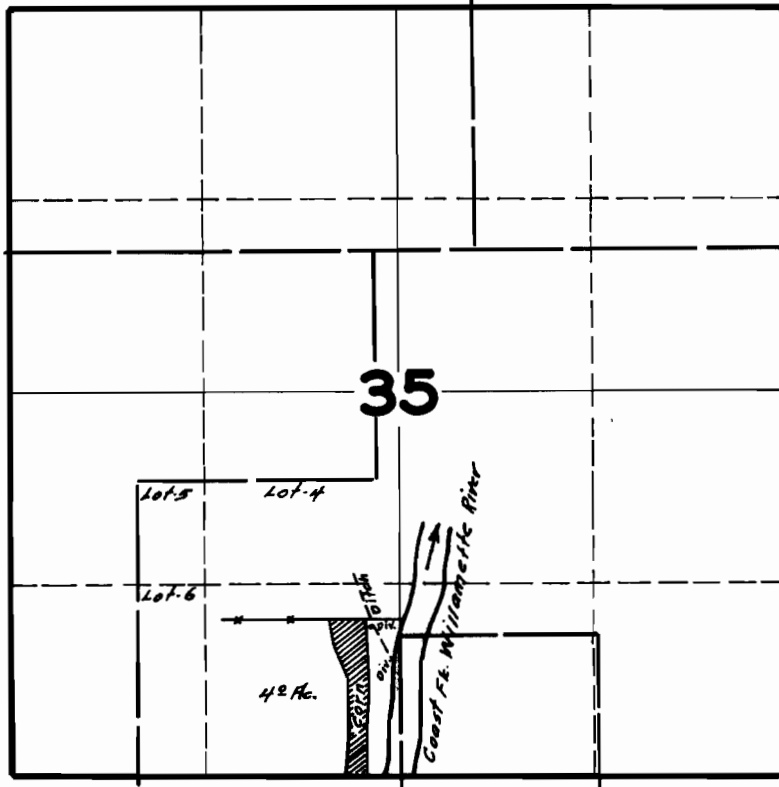

**FINAL PROOF SURVEY  
UNDER**

Application No. 18781 Permit No. 14426

IN NAME OF

RALPH E. WRIGHT

Surveyed JULY 24 1946, by J. D. Sumrell