


# T. IS. RIE & IW. W. M.

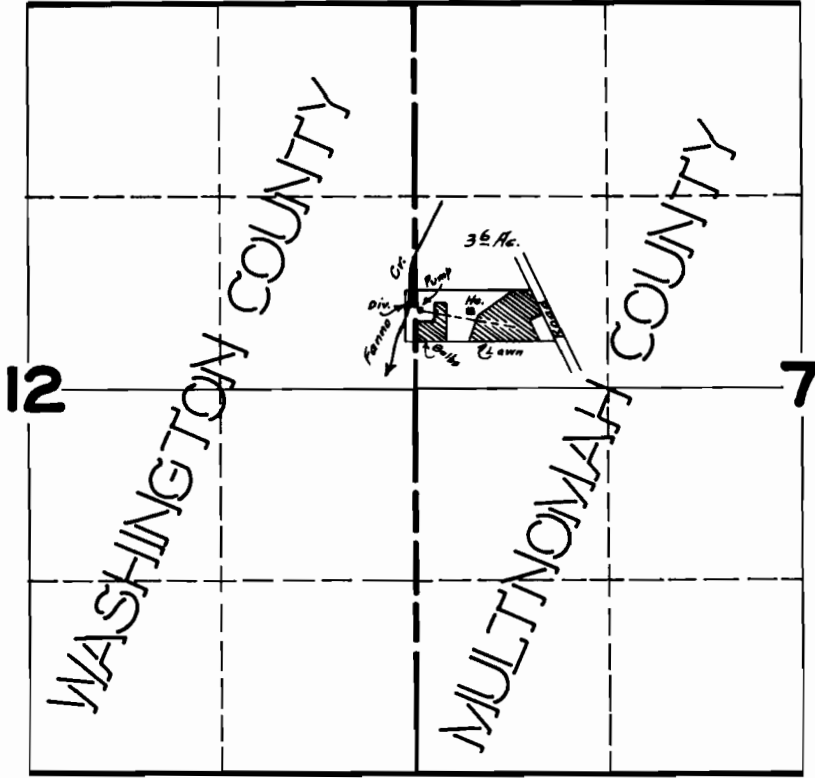

## FINAL PROOF SURVEY UNDER

Application No. 18870 Permit No. 14500

IN NAME OF

WILLIAM A. BRUSHOFF

Surveyed SEP. 12 1946. by