


T. 2N.R. 4W.W.M.

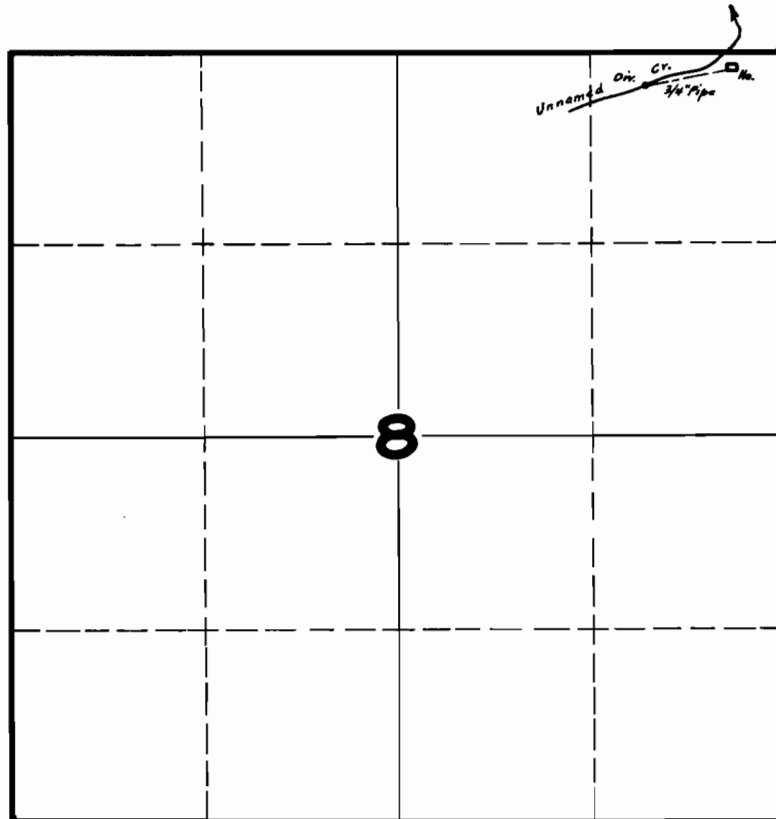

**FINAL PROOF SURVEY
UNDER**

Application No. 18934 Permit No. 14540

IN NAME OF

ALFRED LILLY

Surveyed SEP. 11, 1946, by

[Handwritten signature]