


T.7S.R.19E.W.M.

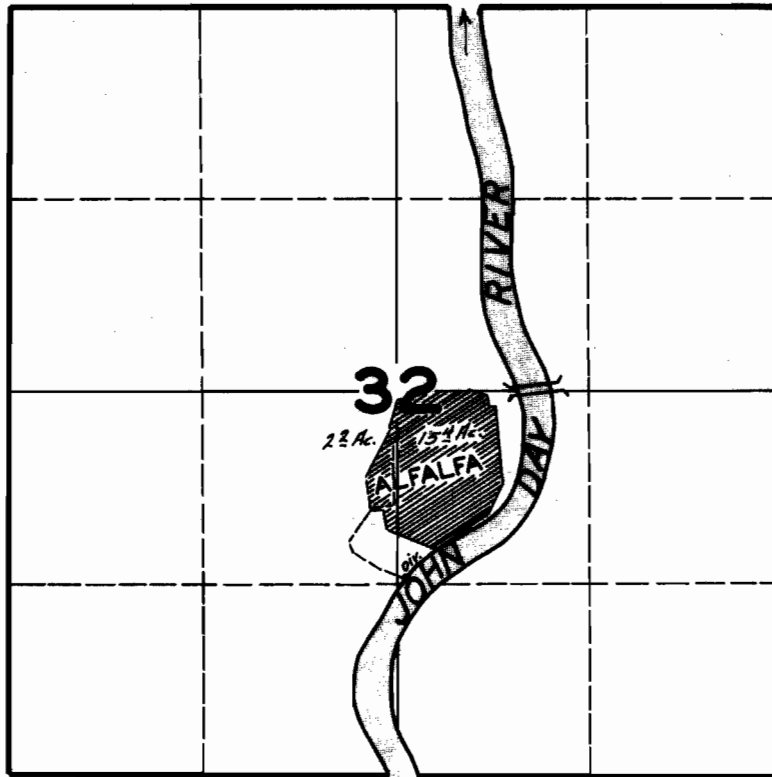

FINAL PROOF SURVEY

UNDER

Application No. 18943 Permit No. 14546

IN NAME OF

DONALD H. McRAE & KATHERINE DILLARD

Surveyed APR. 14 1946, by JAS. E. BUNNELL