


T. I I S. R. I E. W. M.

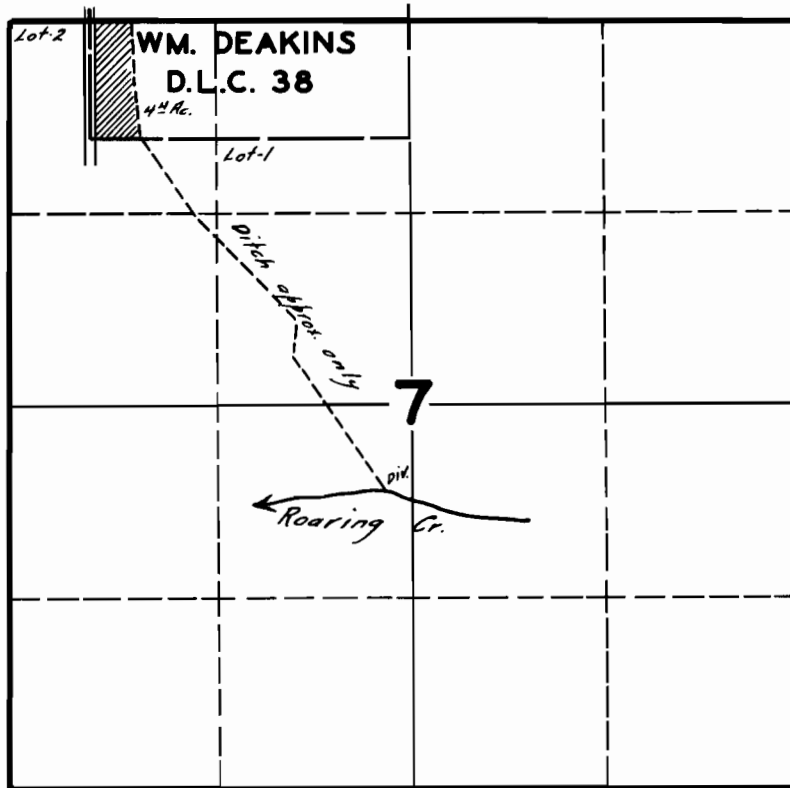

FINAL PROOF SURVEY UNDER

Application No. 19008 Permit No. 14620

IN NAME OF
EMIL HOLUB

Surveyed MAY 14 1946 by [Signature]