


T. 2 S. R. 1 E. W. M.

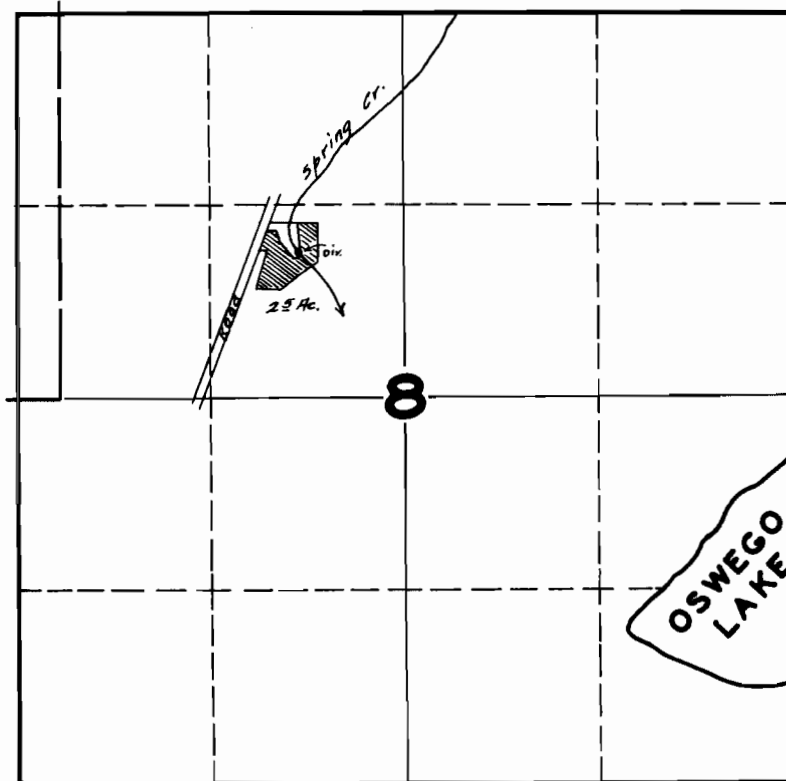

FINAL PROOF SURVEY
UNDER

Application No. 18836 Permit No. 14694

IN NAME OF

WALTER H. ROSS

Surveyed JUNE 17 1946 by

A handwritten signature in cursive script, likely of the surveyor, is written over the text 'by'.