


# T. IS. R. I. W. W. M.

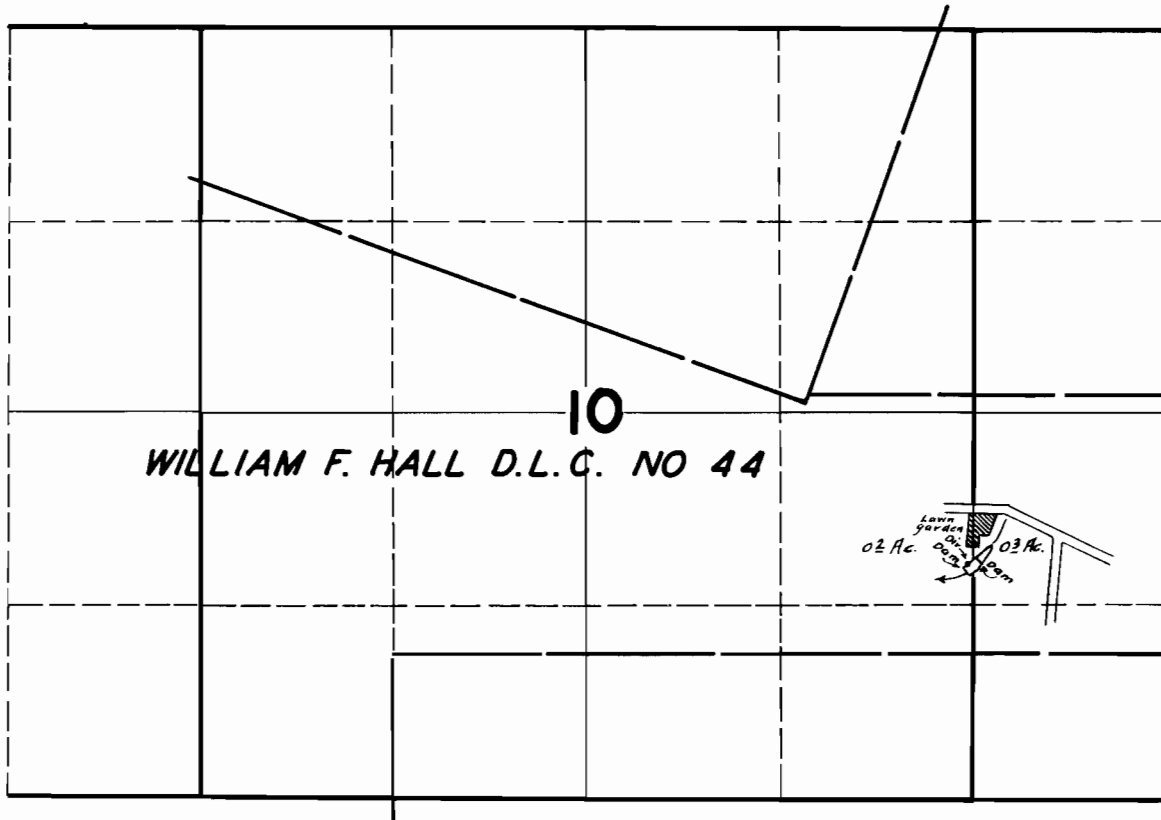

## FINAL PROOF SURVEY

UNDER

Application No. 19184 Permit No. 14781

IN NAME OF

JOHN A. AND MARION BOSCOVICH

Surveyed AUG. 21 1946, by

*James Russell*