


T. 2 S. R. 1 E. W. M.

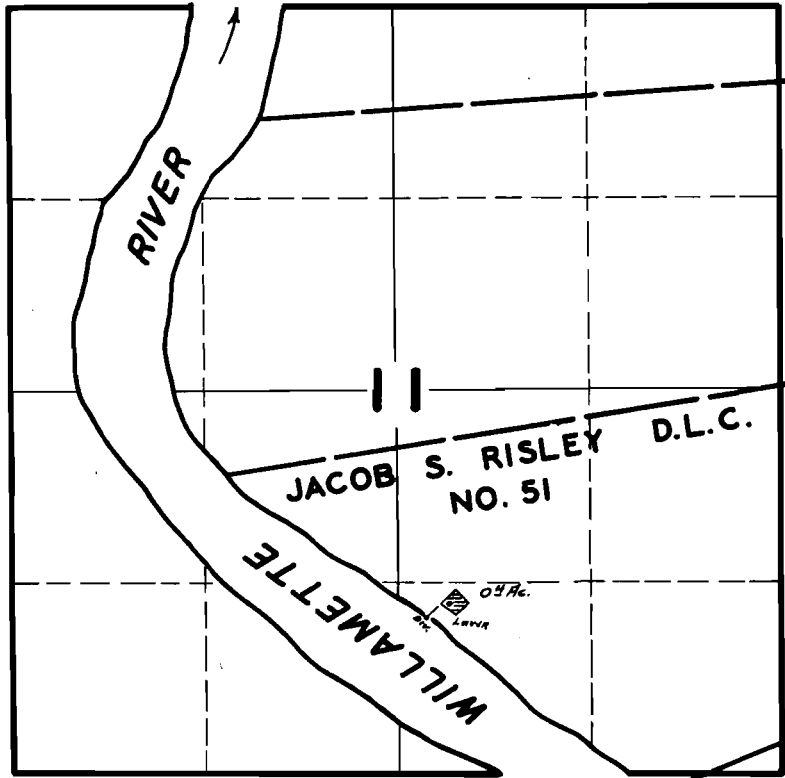

FINAL PROOF SURVEY

UNDER

Application No. 19333 Permit No. 14925

IN NAME OF

V. A. THOMAS

Surveyed JUNE 13 1946 by