T.8S.R.4W.W.M.

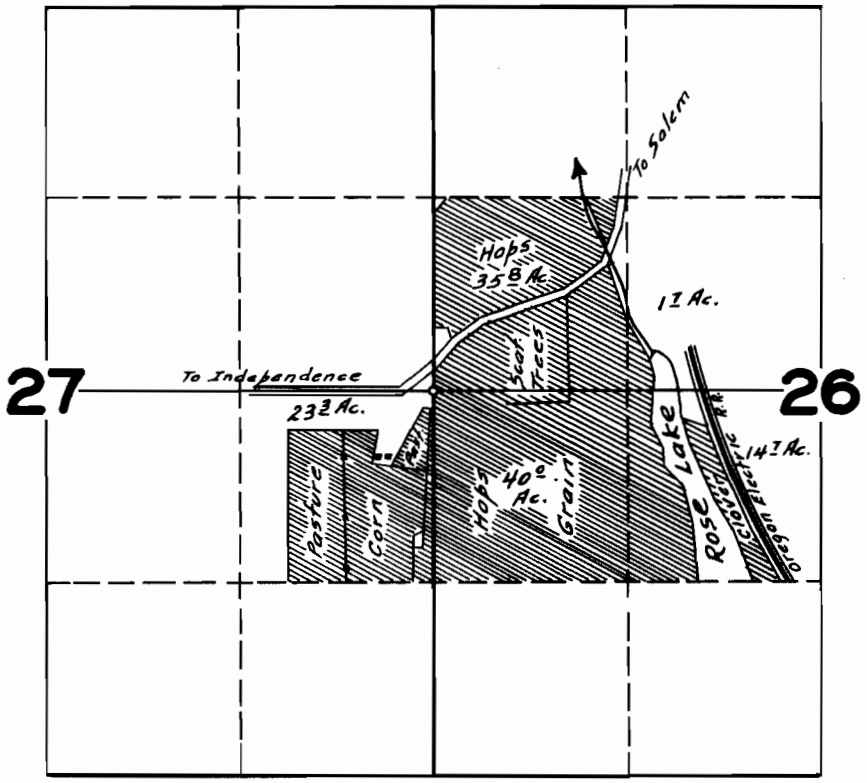

FINAL PROOF SURVEY

UNDER

Application No. 19406 Permit No. 14973

IN NAME OF

D. P. MacCARTHY

Surveyed APR. 1 1946, by [illegible] Burnell

1946 – A