


T.19S.R.47E.W.M.

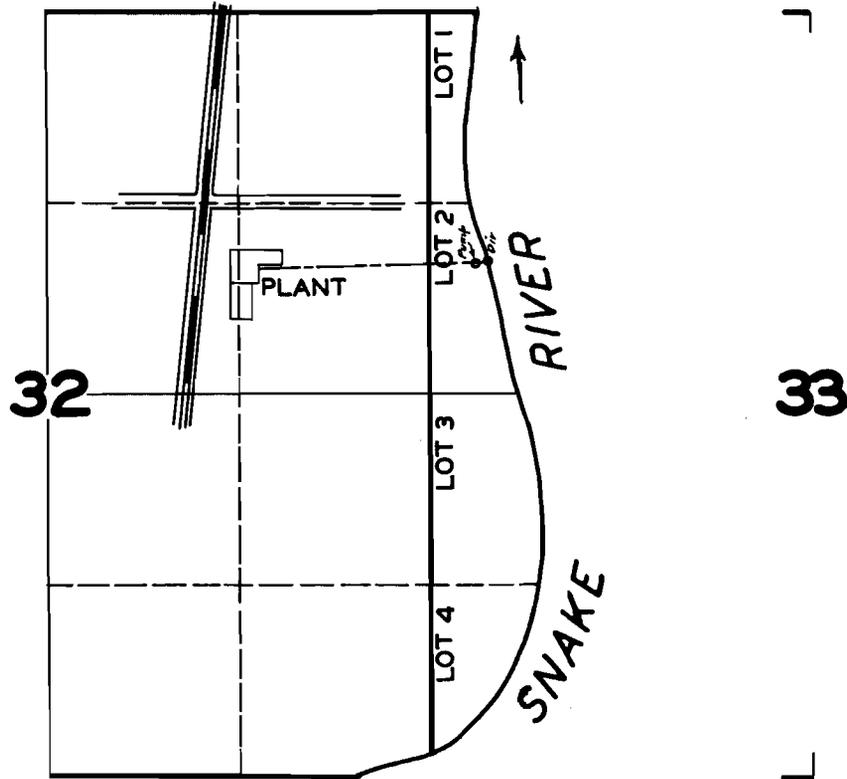

FINAL PROOF SURVEY
UNDER

Application No. 19387 Permit No. 14990

IN NAME OF

THE AMALGAMATED SUGAR COMPANY

Surveyed MAY 28, 1946, by

[Handwritten signature]