


T. 17S. R. 6W. W.M.

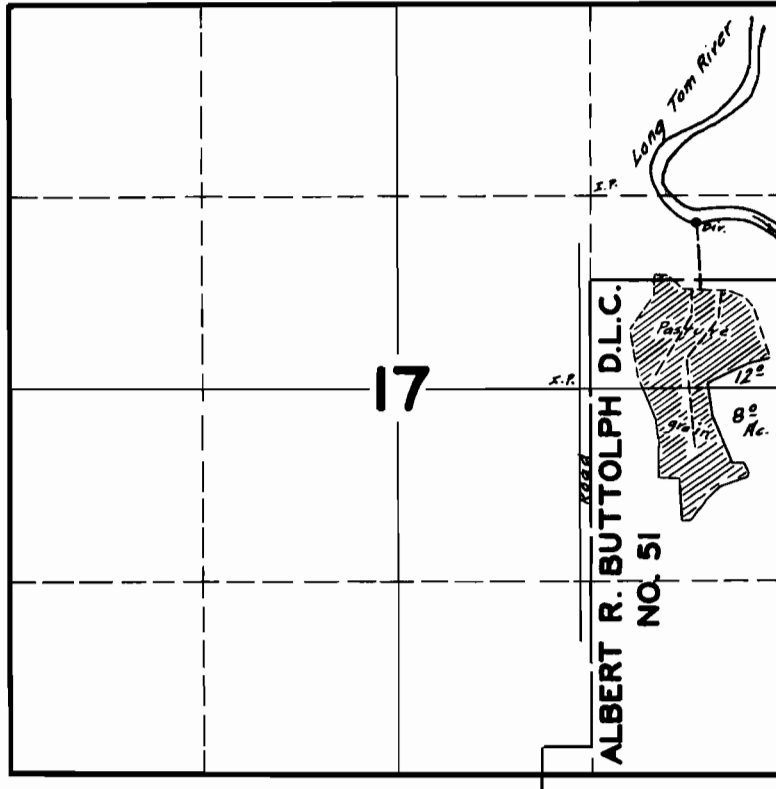

FINAL PROOF SURVEY UNDER

Application No. 19476 Permit No. 15059

IN NAME OF

EDWIN E. GLEASON

Surveyed AUG. 2, 1946, by

[Handwritten Signature]