


# T.8S. R.11W.W.M.

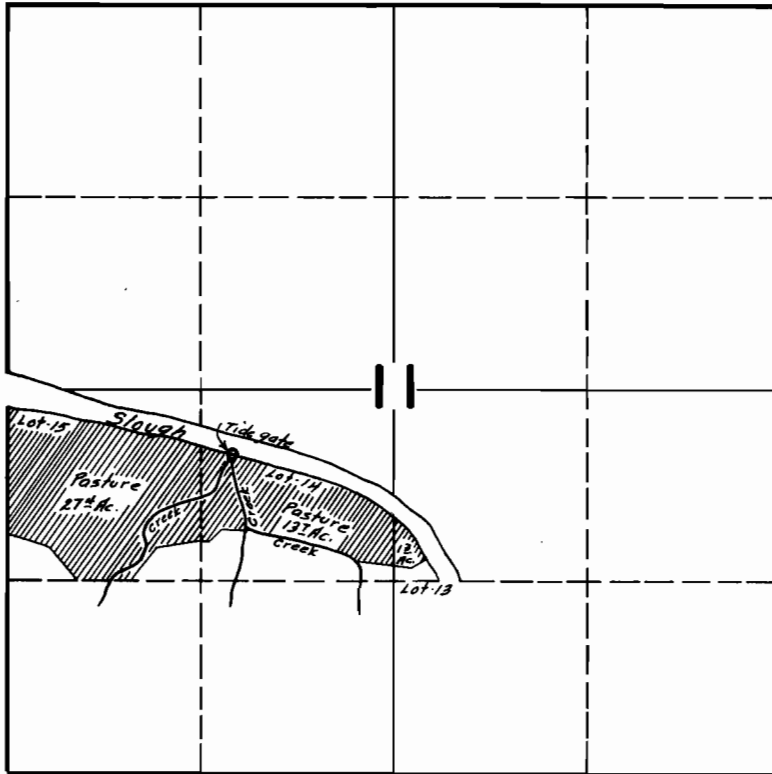

## FINAL PROOF SURVEY UNDER

Application No. 19148 Permit No. 15082

IN NAME OF

MR. & MRS. A.C. JACKSON

Surveyed AUG. 21, 1945, by J. H. Russell