


Per 15132
1947

T.11S. R.30E. W.1M.

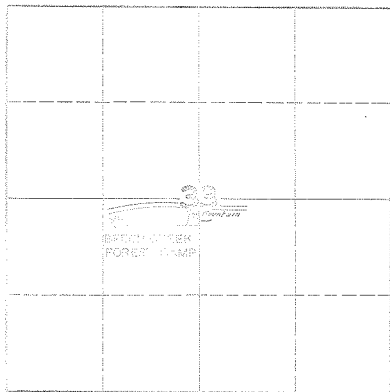

FINAL PROOF SURVEY
UNDER

Application No. 19546... Permit No. 15132

IN NAME OF

U. S. FOREST SERVICE - MALHEUR NATIONAL FOREST

Surveyed APR. 23 1946