


**T.5N.R.35E.W.M.**

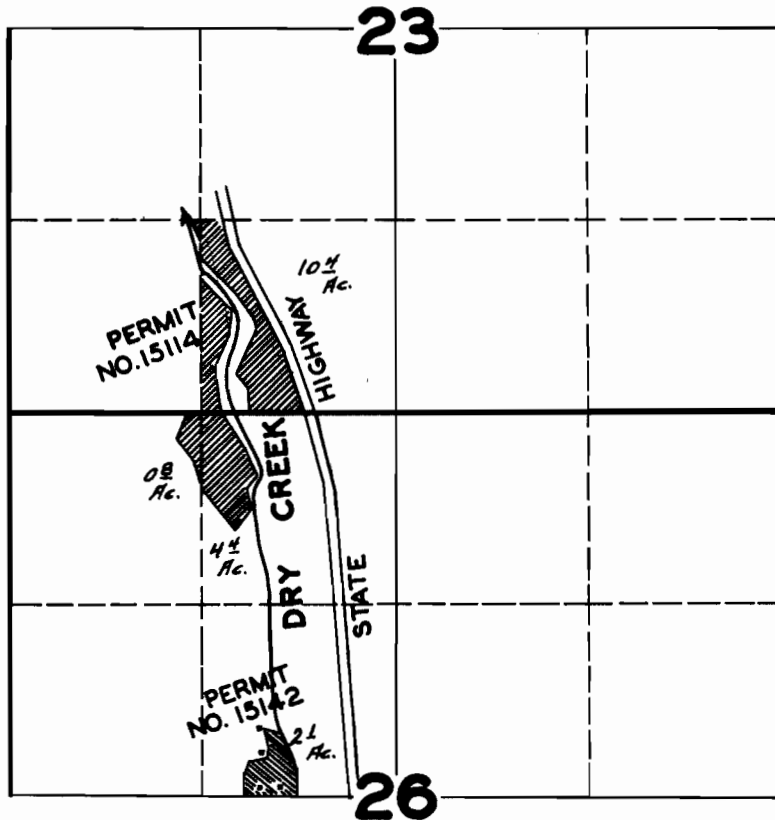

**FINAL PROOF SURVEY**

UNDER

Application No. 19 523 Permit No. 15114  
Application No. 19 559 Permit No. 15142

IN NAME OF

WM. H. STEEN

Surveyed APR. 18, 1946, by JAS. E. BUNNELL