


**T. 6N. R. 35E. W. M.**

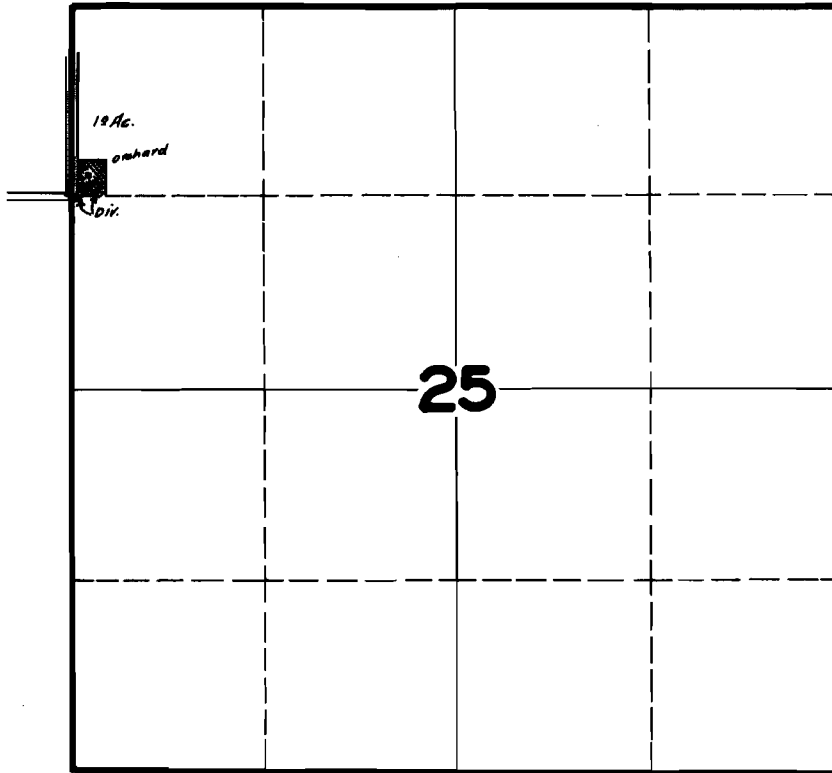

**FINAL PROOF SURVEY  
UNDER**

**Application No. 19697 Permit No. 15276**

**IN NAME OF**

**MAMIE HOWELL**

**Surveyed APR. 20 1946, by JAS. E. BUNNELL**