


T.1&2N. R.2W.W.M.

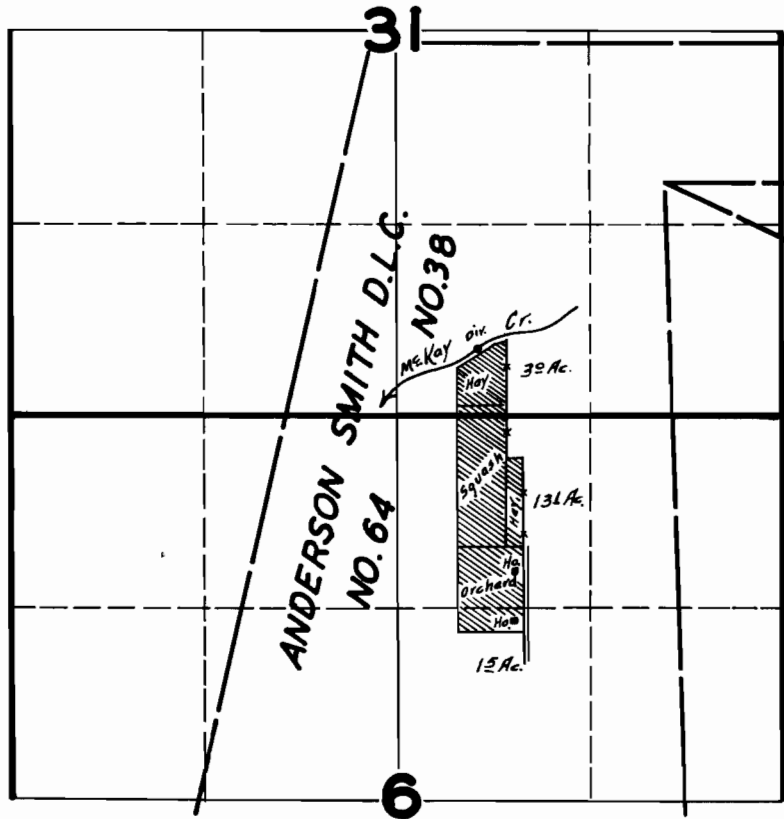

FINAL PROOF SURVEY
UNDER

Application No. 19725 Permit No. 15296

IN NAME OF

LEE W. KALLENBACH

Surveyed AUG. 28 1946, by