


T.3S.R.4E.W.M.

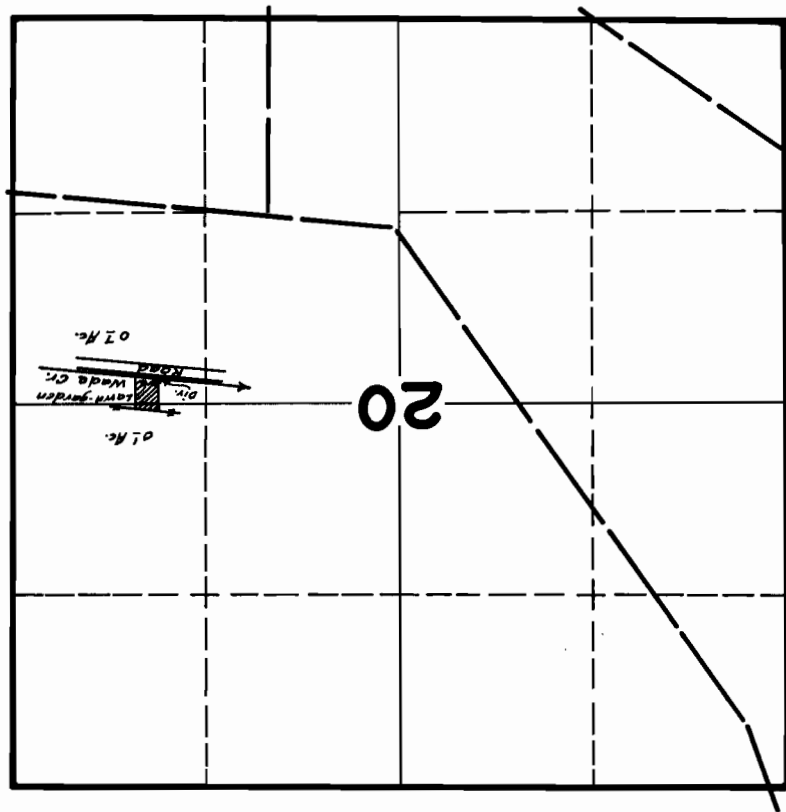

FINAL PROOF SURVEY

UNDER

Application No. 19739 Permit No. 15326

IN NAME OF

O.V. COOP

Surveyed JUNE 201946 BY *[Signature]*