


T. 2 S. R. 1 E. W. M.

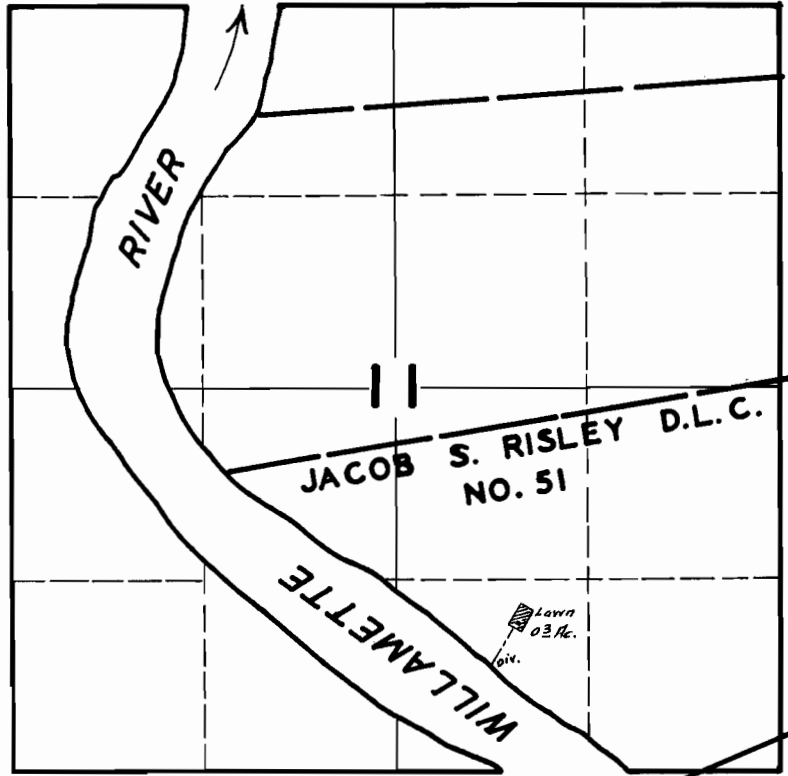

FINAL PROOF SURVEY UNDER

Application No. 19925 Permit No. 15499

IN NAME OF

W. E. CLANCY

Surveyed JUNE 16 1946, by

[Handwritten Signature]