


T.2S.R.45E.W.M.

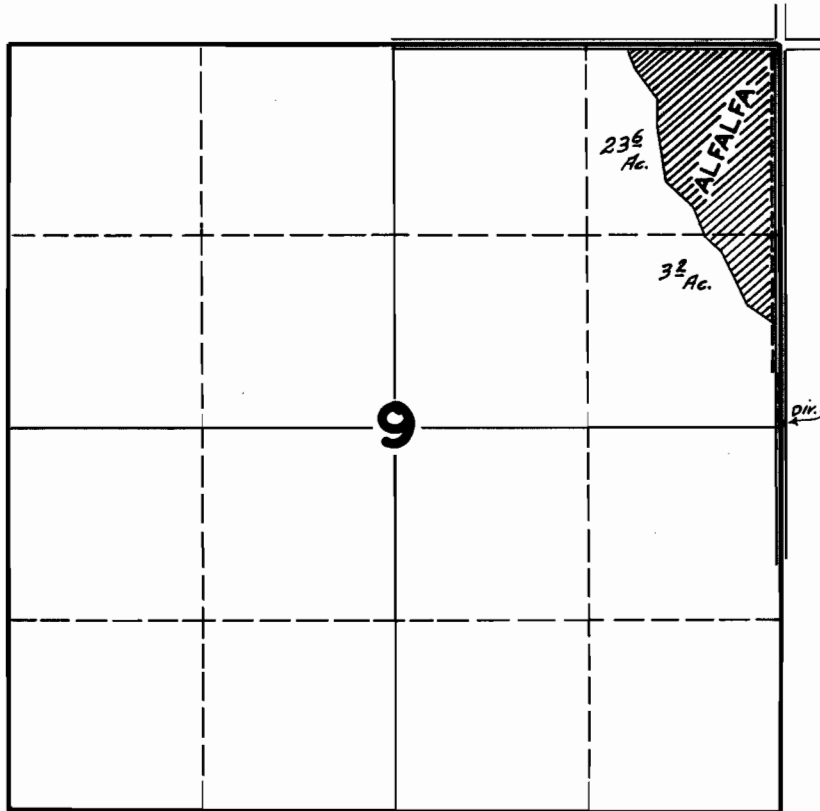

**FINAL PROOF SURVEY
UNDER**

Application No. 19964 Permit No. 15534

IN NAME OF

MR. ELMER McFETRIDGE

Surveyed JUNE 26 1946, by JAS. E. BUNNELL