


T.4S. R.40E.W.M.

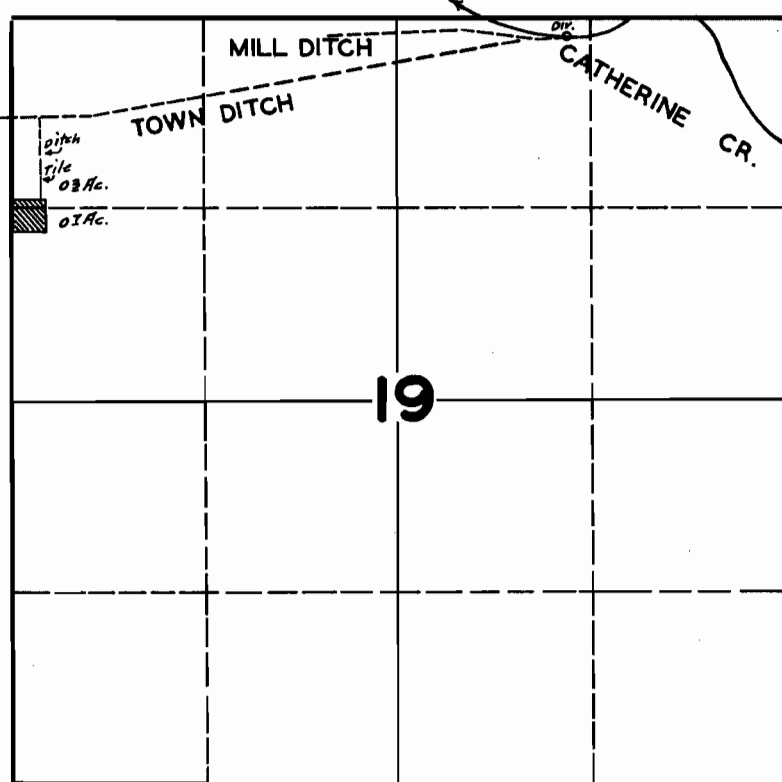

**FINAL PROOF SURVEY
UNDER**

Application No. 19978 Permit No. 15544

IN NAME OF

C.L. SCOTT & MARY SCOTT

Surveyed JUNE 29 1946, by JAS. E. BUNNELL