


T.5S.R.4W.W.M.

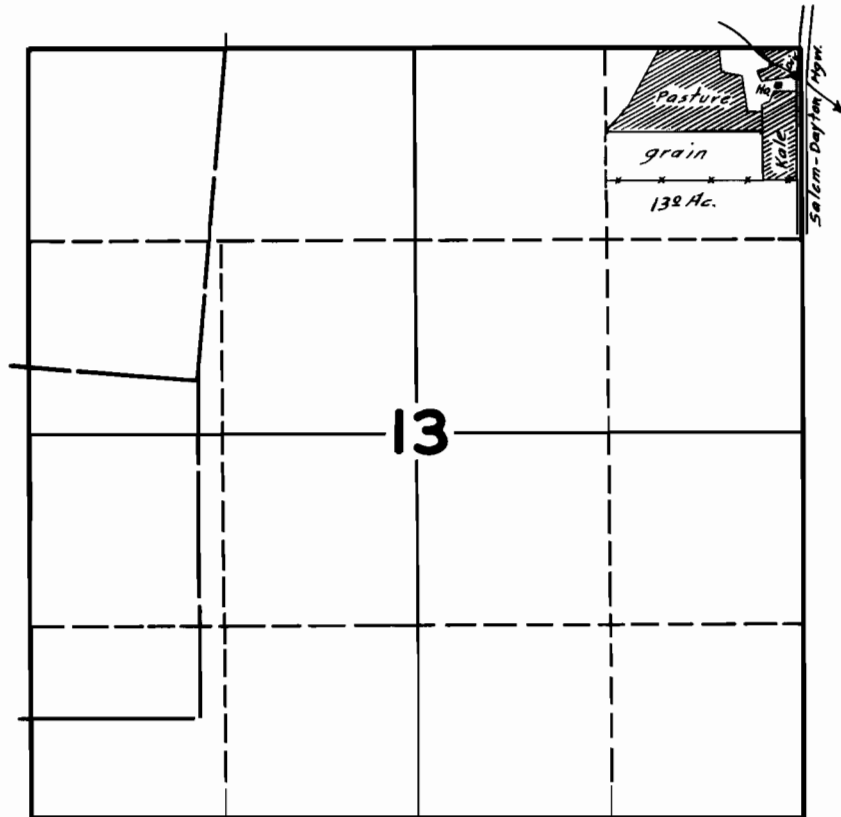

FINAL PROOF SURVEY

UNDER

Application No. 19990 Permit No. 15554

IN NAME OF

RUTSCHMAN & SON

Surveyed AUG. 13 1946, by

[Handwritten Signature] Sumrell