


T.6S. R.2E.W.M.

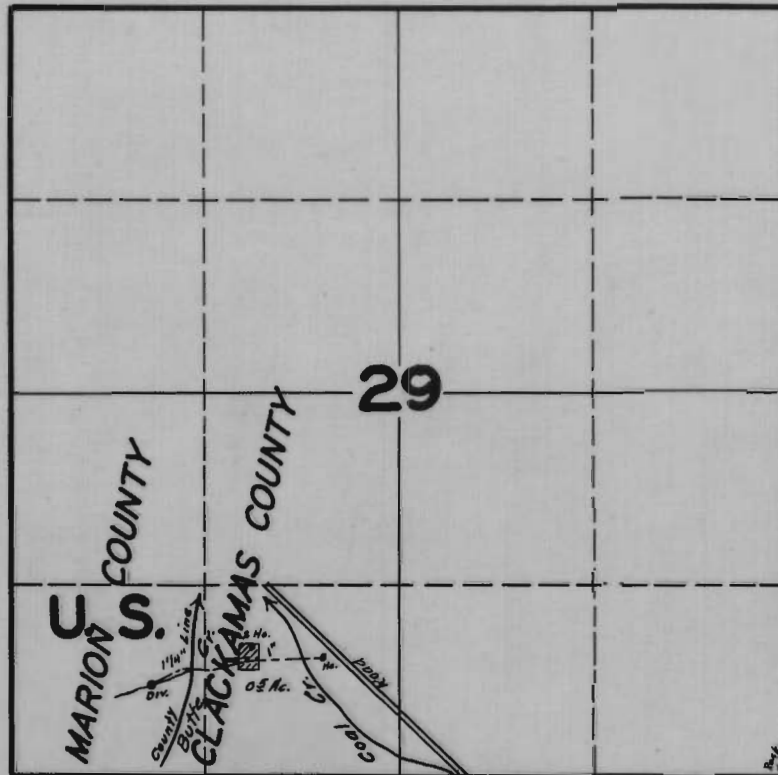

FINAL PROOF SURVEY
UNDER

Application No. 20019 Permit No. 15590

IN NAME OF

E. H. KELLER

Surveyed MAY 8 1945, by

[Signature]