


T.17&18S. R.10W.W.M.

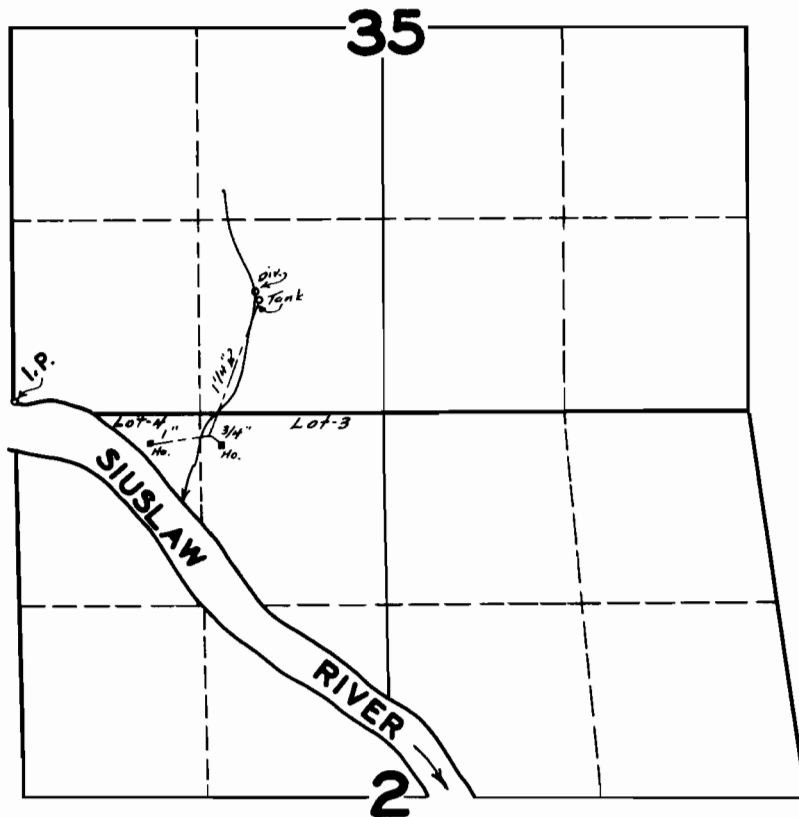

FINAL PROOF SURVEY
UNDER

Application No. 20108 Permit No. 15666

IN NAME OF

J. U. GOUDE & D. F. PLUM

Surveyed AUG. 7, 1946, by [Signature]