


15672

**T.2N.R.14E.W.M.**

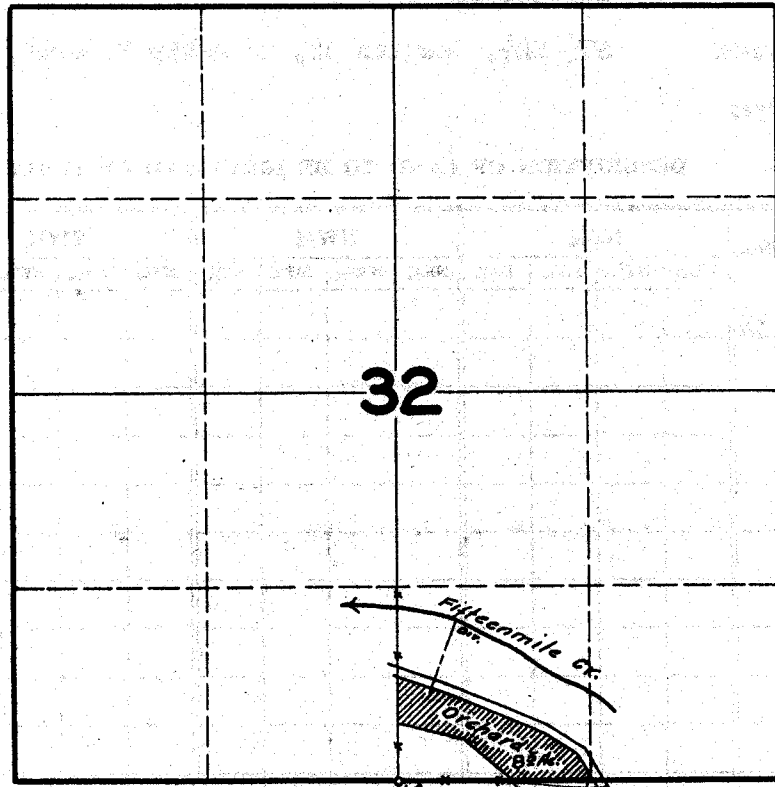

**FINAL PROOF SURVEY**

UNDER

Application No. 20119 Permit No. 15672

IN NAME OF

I. O. AND ALMA TENOLD

Surveyed APR. 11, 1946, by JAS. E. BUNNELL