


T. IS. R. 2 W. W. M.

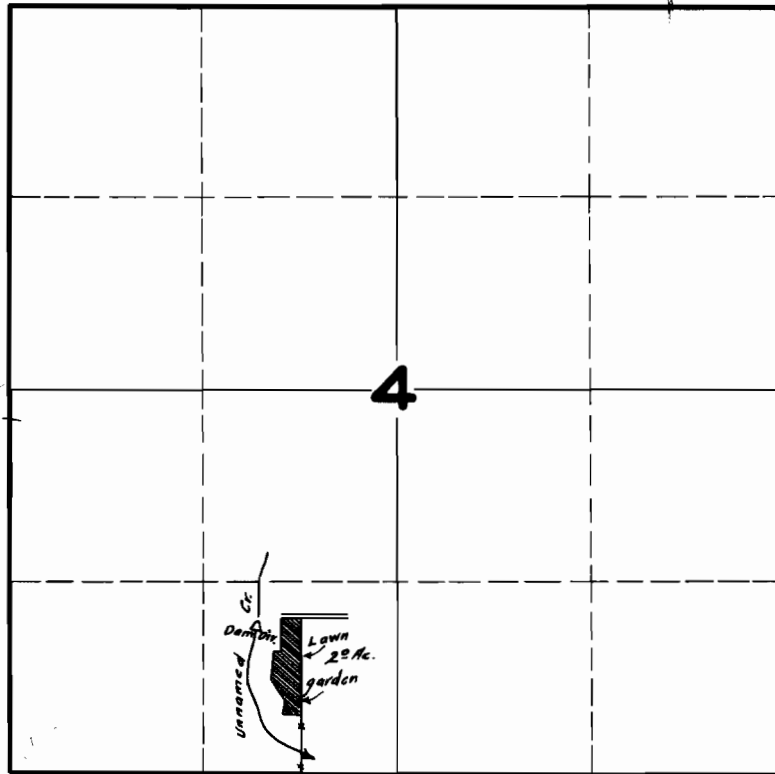

FINAL PROOF SURVEY UNDER

Application No. 20134 Permit No. 15696

IN NAME OF

WILLIAM H. CHAPMAN

Surveyed AUG. 19 1946, by *[Signature]*