


T.3S.R.1E.W.M.

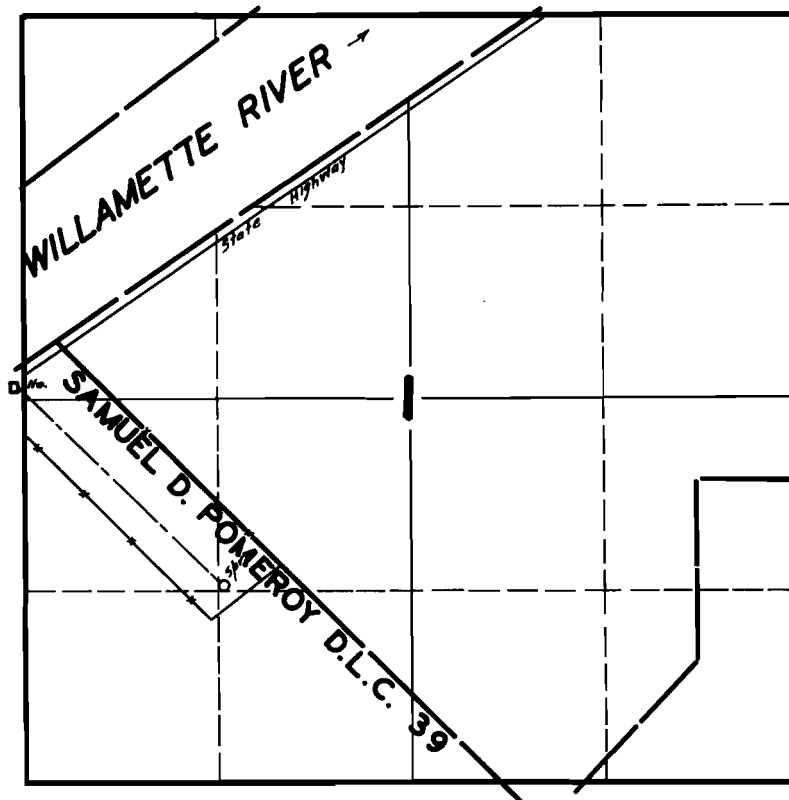

FINAL PROOF SURVEY

UNDER

Application No. 20150 Permit No. 15704

IN NAME OF

A. H. AND CORNELIA LEWIS

Surveyed DEC. 17 1946, by