


T.2S.R.37E.W.M.

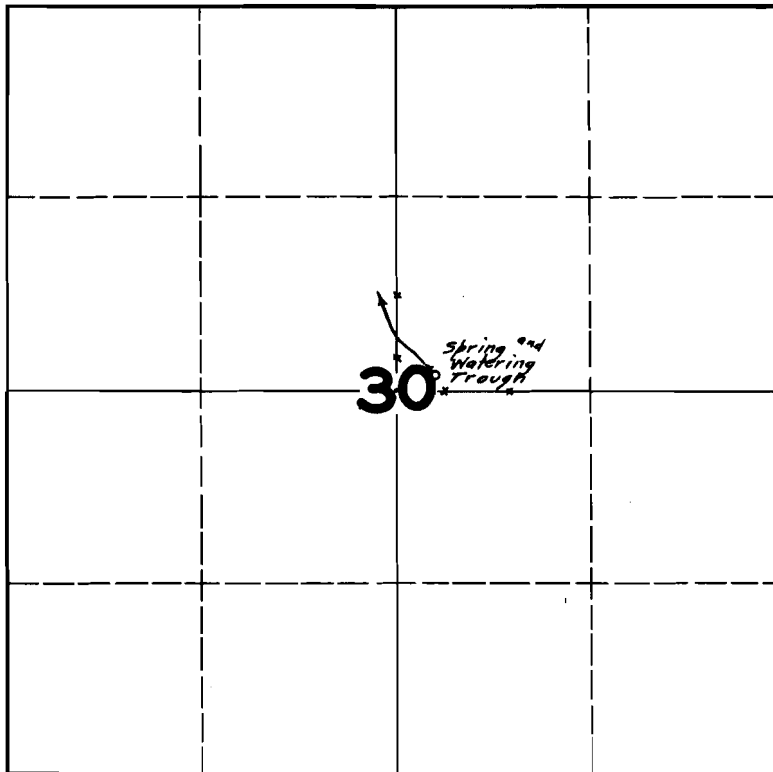

**FINAL PROOF SURVEY
UNDER**

Application No. 20215 Permit No. 15764

IN NAME OF

U.S. DEPARTMENT OF AGRICULTURE - FOREST SERVICE

Surveyed JULY 1, 1946, by JAS. E. BUNNELL