


T. I. S. R. I. W. W. M.

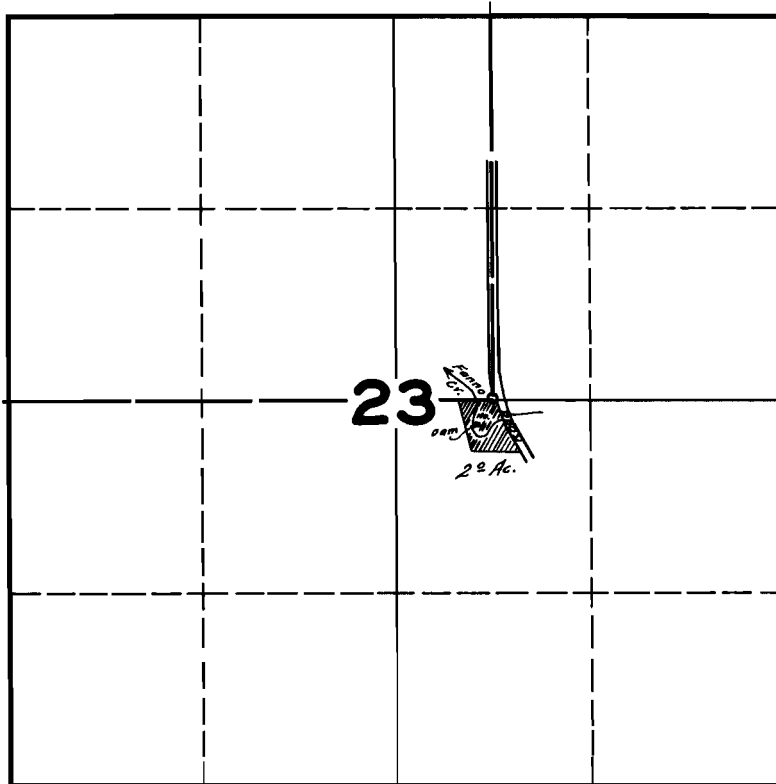

FINAL PROOF SURVEY

UNDER

Application No. 20260... Permit No. 15795

IN NAME OF

WILBUR D. STAATS

Surveyed AUG. 28 1945 by

A large, stylized handwritten signature in black ink, written over the text 'Surveyed AUG. 28 1945 by'.