


T. 2 S. R. 3 W. W. M.

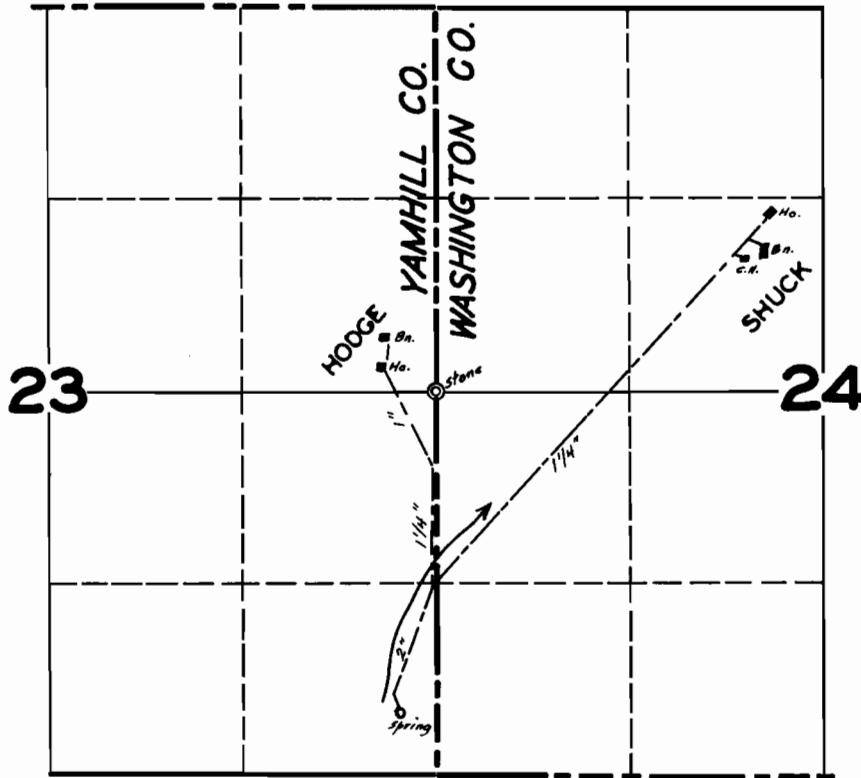

FINAL PROOF SURVEY UNDER

Application No. 20214 Permit No. 15805

IN NAME OF

C. H. HODGE & CLARIBEL M. SHUCK

Surveyed JUNE 13 1945, by *[Signature]*