


T. IS. R. I. E. W. M.

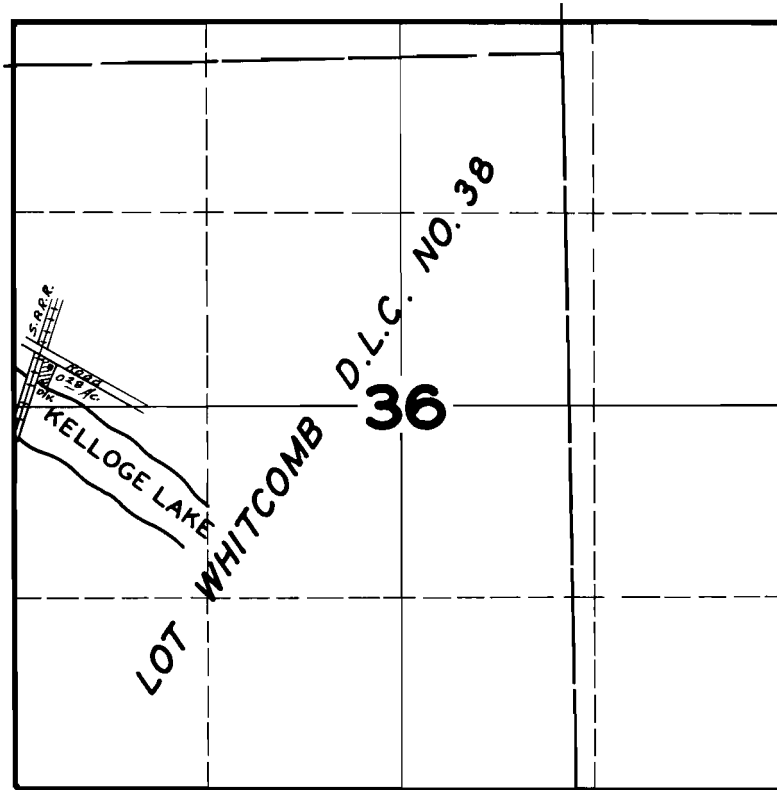

FINAL PROOF SURVEY

UNDER

Application No. 20313 Permit No. 15847

IN NAME OF

E. R. BENNETT & FLORENCE BENNETT

Surveyed JUNE 11 1946 by [Signature]