


T.5S.R.1W.W.M.

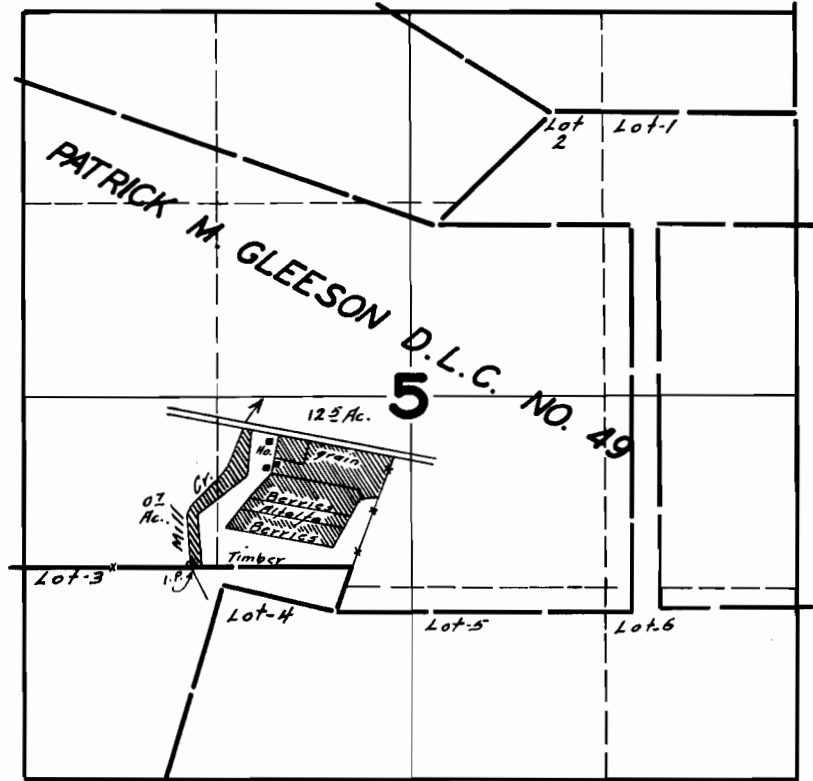

FINAL PROOF SURVEY UNDER

Application No. 20363 Permit No. 15885

IN NAME OF

ALFRED HANAUSKA

Surveyed APR. 3 1946, by

J. P. Sumrell