


# T.3S. R.9W.W.M.

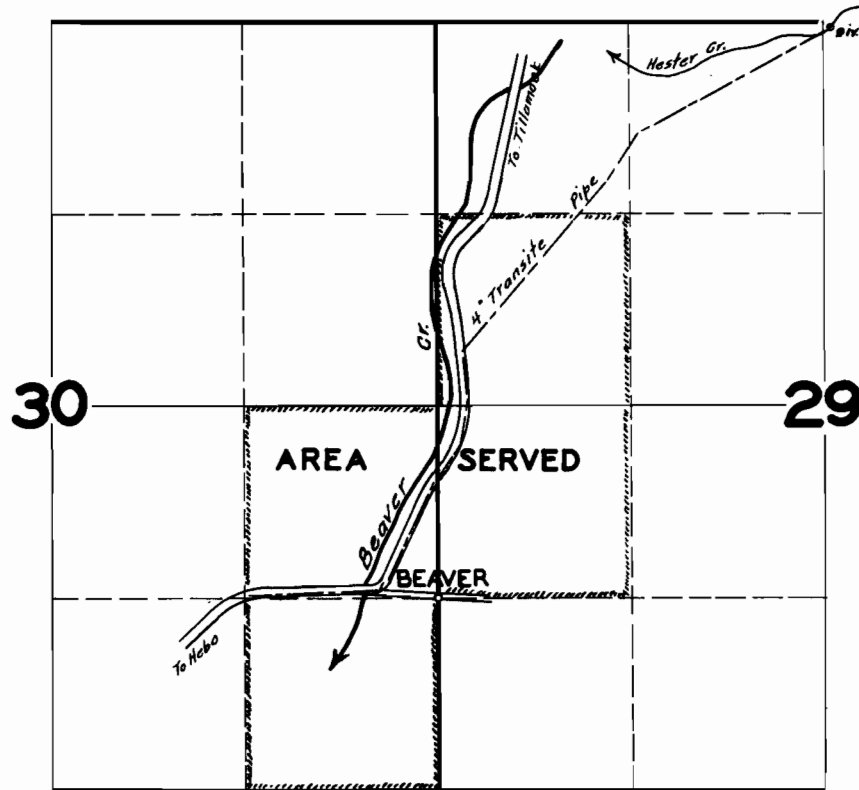

## FINAL PROOF SURVEY UNDER

Application No. 20301 Permit No. 15912

IN NAME OF

BEN L. BECKER

Surveyed JULY 18 1946, by *[Signature]*