


T. I. S. R. 2 W. W. M.

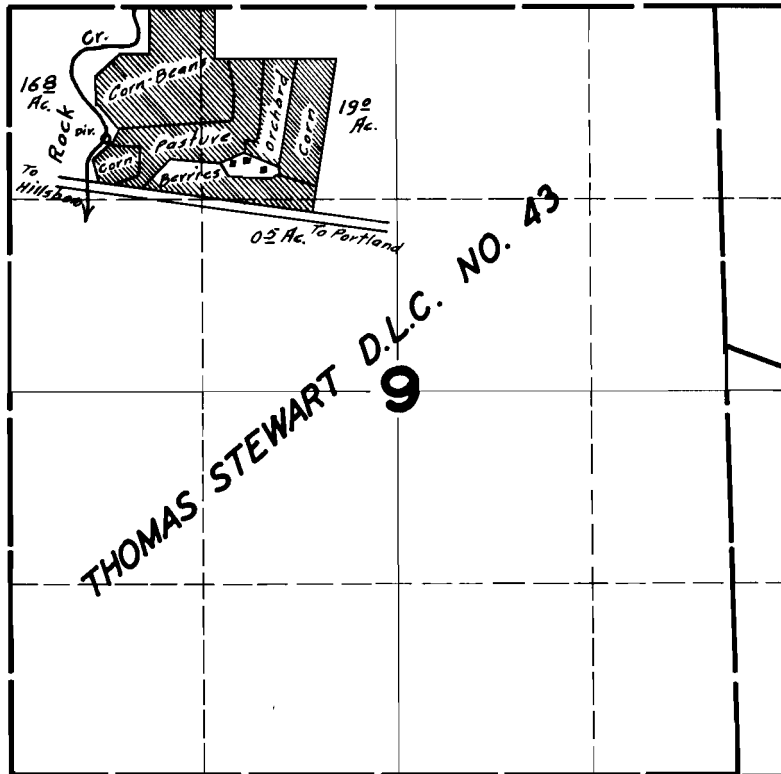

FINAL PROOF SURVEY UNDER

Application No. 20435 Permit No. 15955

IN NAME OF

EBBA CAROTHERS & ED. CAROTHERS

Surveyed AUG. 19 1946, by