


T. IS. R. IW. W. M.

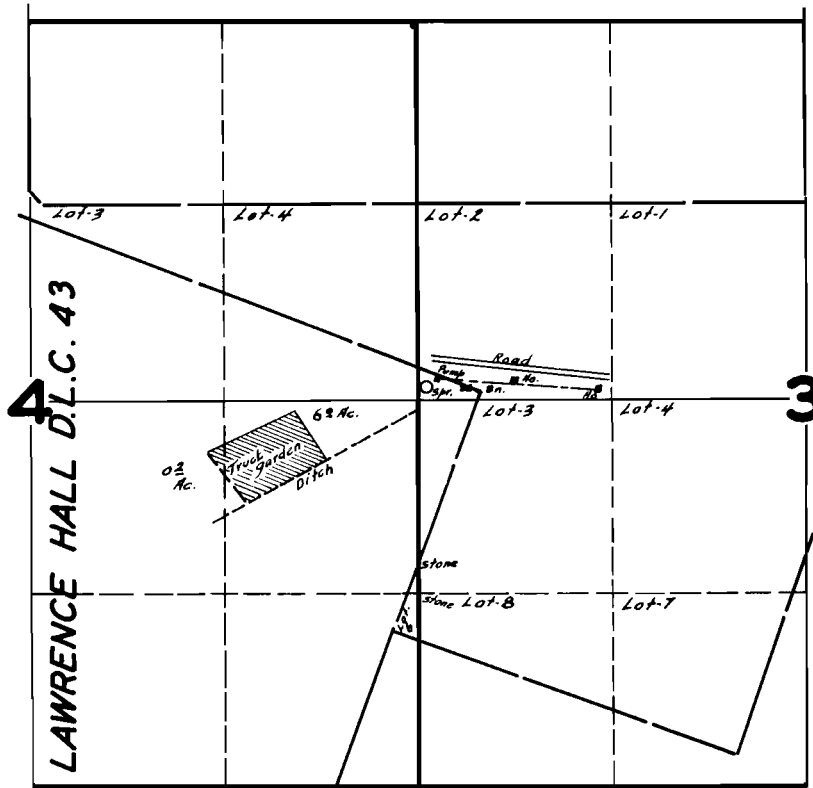

FINAL PROOF SURVEY UNDER

Application No. 20455 Permit No. 15972

IN NAME OF

JOHN & HENRY JOHNSON

Surveyed AUG. 29 1945, by *[Signature]*