


T. 13S. R. 1E. W. M.

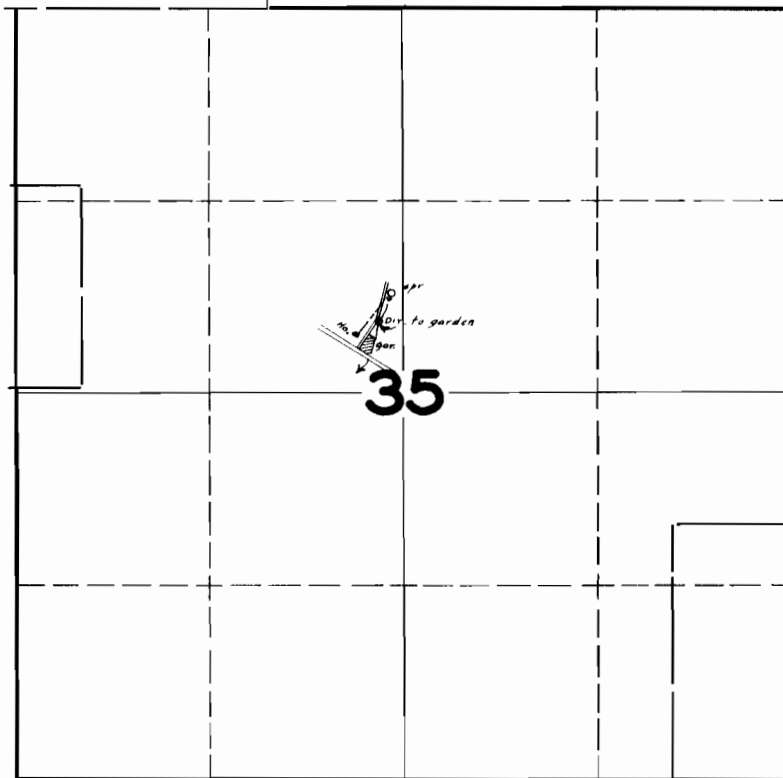

FINAL PROOF SURVEY UNDER

Application No. 20466 Permit No. 15978

IN NAME OF
ROYCE HINTON

Surveyed JUNE 27 1945, by J. D. Russell