


T. 2S. R. 9W. W.M.

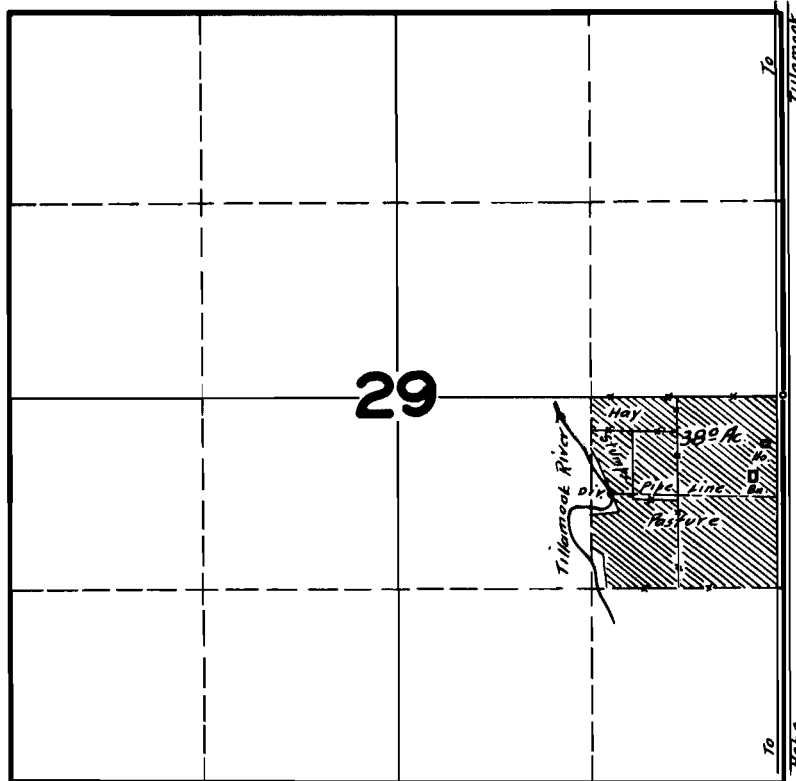

FINAL PROOF SURVEY
UNDER

Application No. 20502 Permit No. 16004

IN NAME OF
JACK GRAE

Surveyed JULY 18 1946, by *[Signature]*