
T.4S,R.10W.W.M.

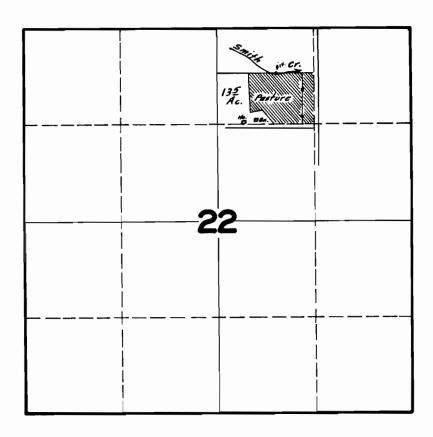

FINAL PROOF SURVEY UNDER

Application No. 20520 Permit No. 16022 IN NAME OF

EDWARD J. HIMES

Surveyed JULY 19 1946